


T.39S. R.11E. W.M.


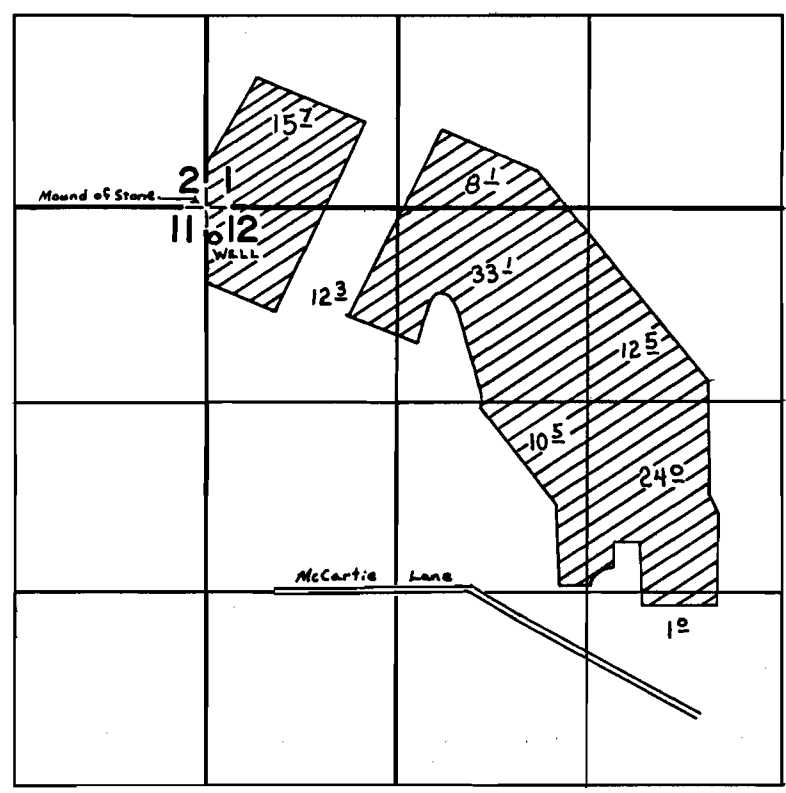

Well Located: 200'S & 50'E from NW Corner Sec. 12

FINAL PROOF SURVEY UNDER

Application No. G-7361 Permit No. G-6814
IN NAME OF

CAMERON A. CURTISS

Surveyed AUG. 18. 1977., by D. NORBY.....