


T39S, R5E, WM

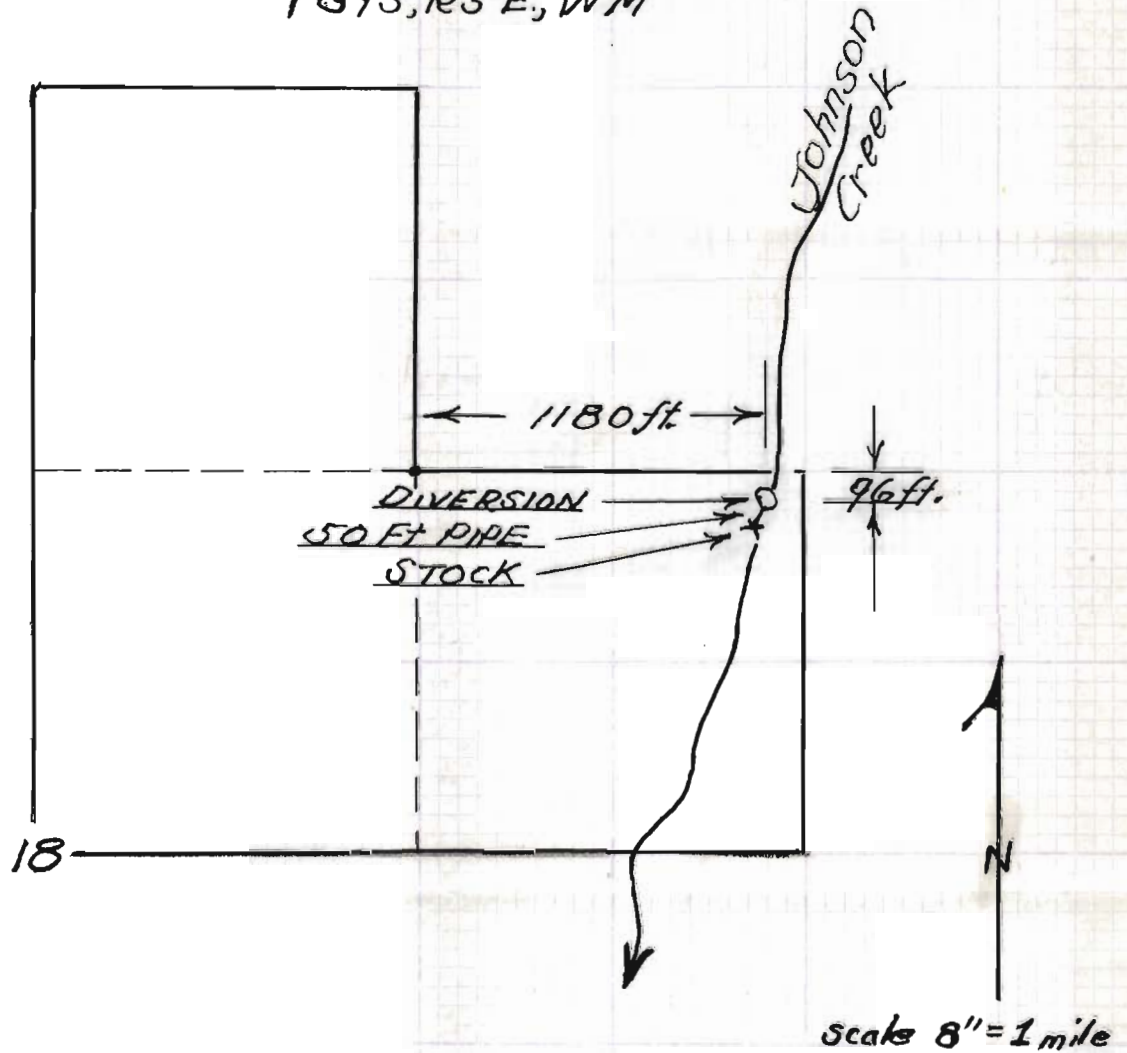

PROPERTY OF  
MAXWELL P. & LOUISE D. GUILLEY

Application No. 39178  
Permit No. 29189

RECEIVED  
OCT 17 1963  
STATE ENGINEER  
SALEM, OREGON