


T.33S. R.18E., W.M.

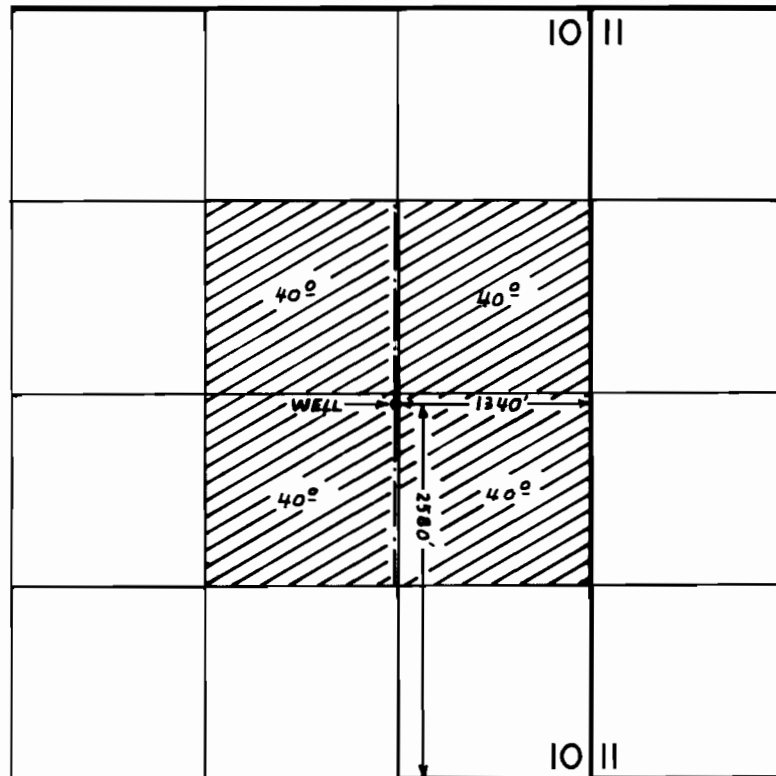

FINAL PROOF SURVEY
UNDER

Application No. G-6125... Permit No. G-5796.
IN NAME OF

.....JOHN V. WITHERS.....

Surveyed JUL 20, 1977, by D.M. NORBY.....