


T.26S. R.19E., W.M.

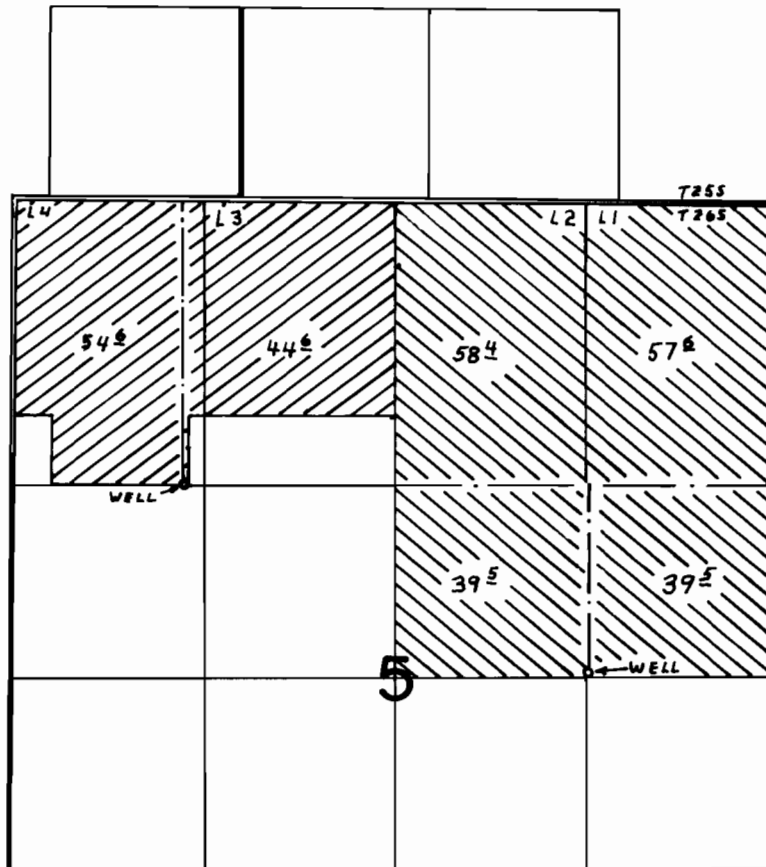

APP'L. G-6535; WELL LOC. 1970'S. & 1190'E. FROM N.W. COR. SEC. 5

APP'L. G-7190; WELL LOC. 3250'S. & 1280'W. FROM N.E. COR. SEC. 5

FINAL PROOF SURVEY UNDER

G-6535 G-6143
Application No. G-7190 Permit No. G-6621
IN NAME OF

LYLE & HELEN DAMEWOOD

Surveyed JUL 19, 1977, by D.M. NORBY