


G-6003
47616

T.27S. R.16E., W.M.

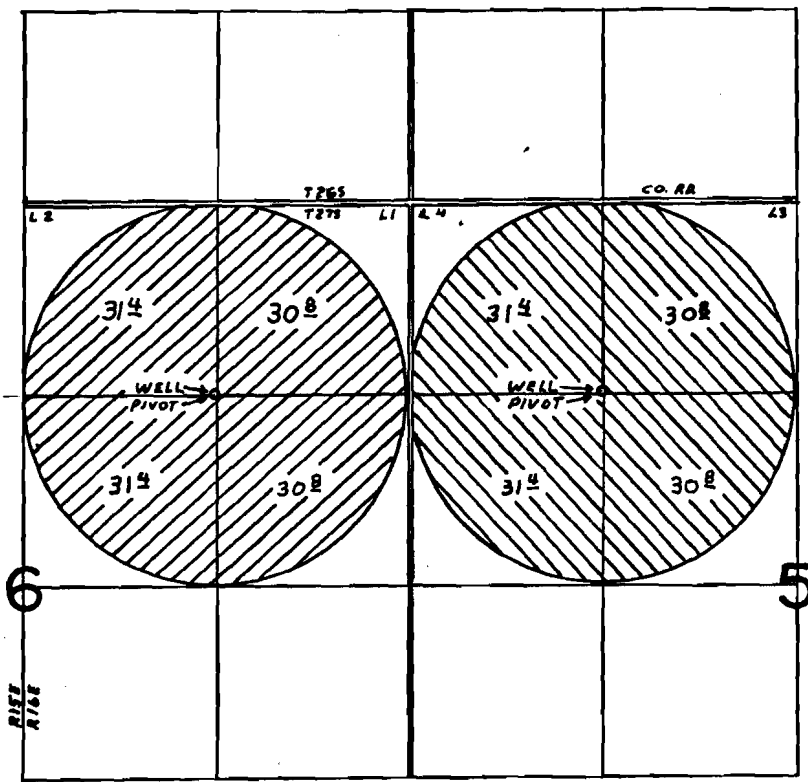

- APP'L. G-6738 ; WELL LOC. 1320'S. & 1340'W. N.E. COR. SEC. 6
- APP'L. G-6775 ; WELL LOC. 1310'S. & 1310'E. N.W. COR. SEC. 5

FINAL PROOF SURVEY UNDER

G-6735 G-6003
Application No. G-6738.. Permit No. G-6006..
IN NAME OF

.....GERALD L. LANIER.....

Surveyed JUL 18, 1977, by D.M. NORBY.....