


Township 36 S., Range 21 E.

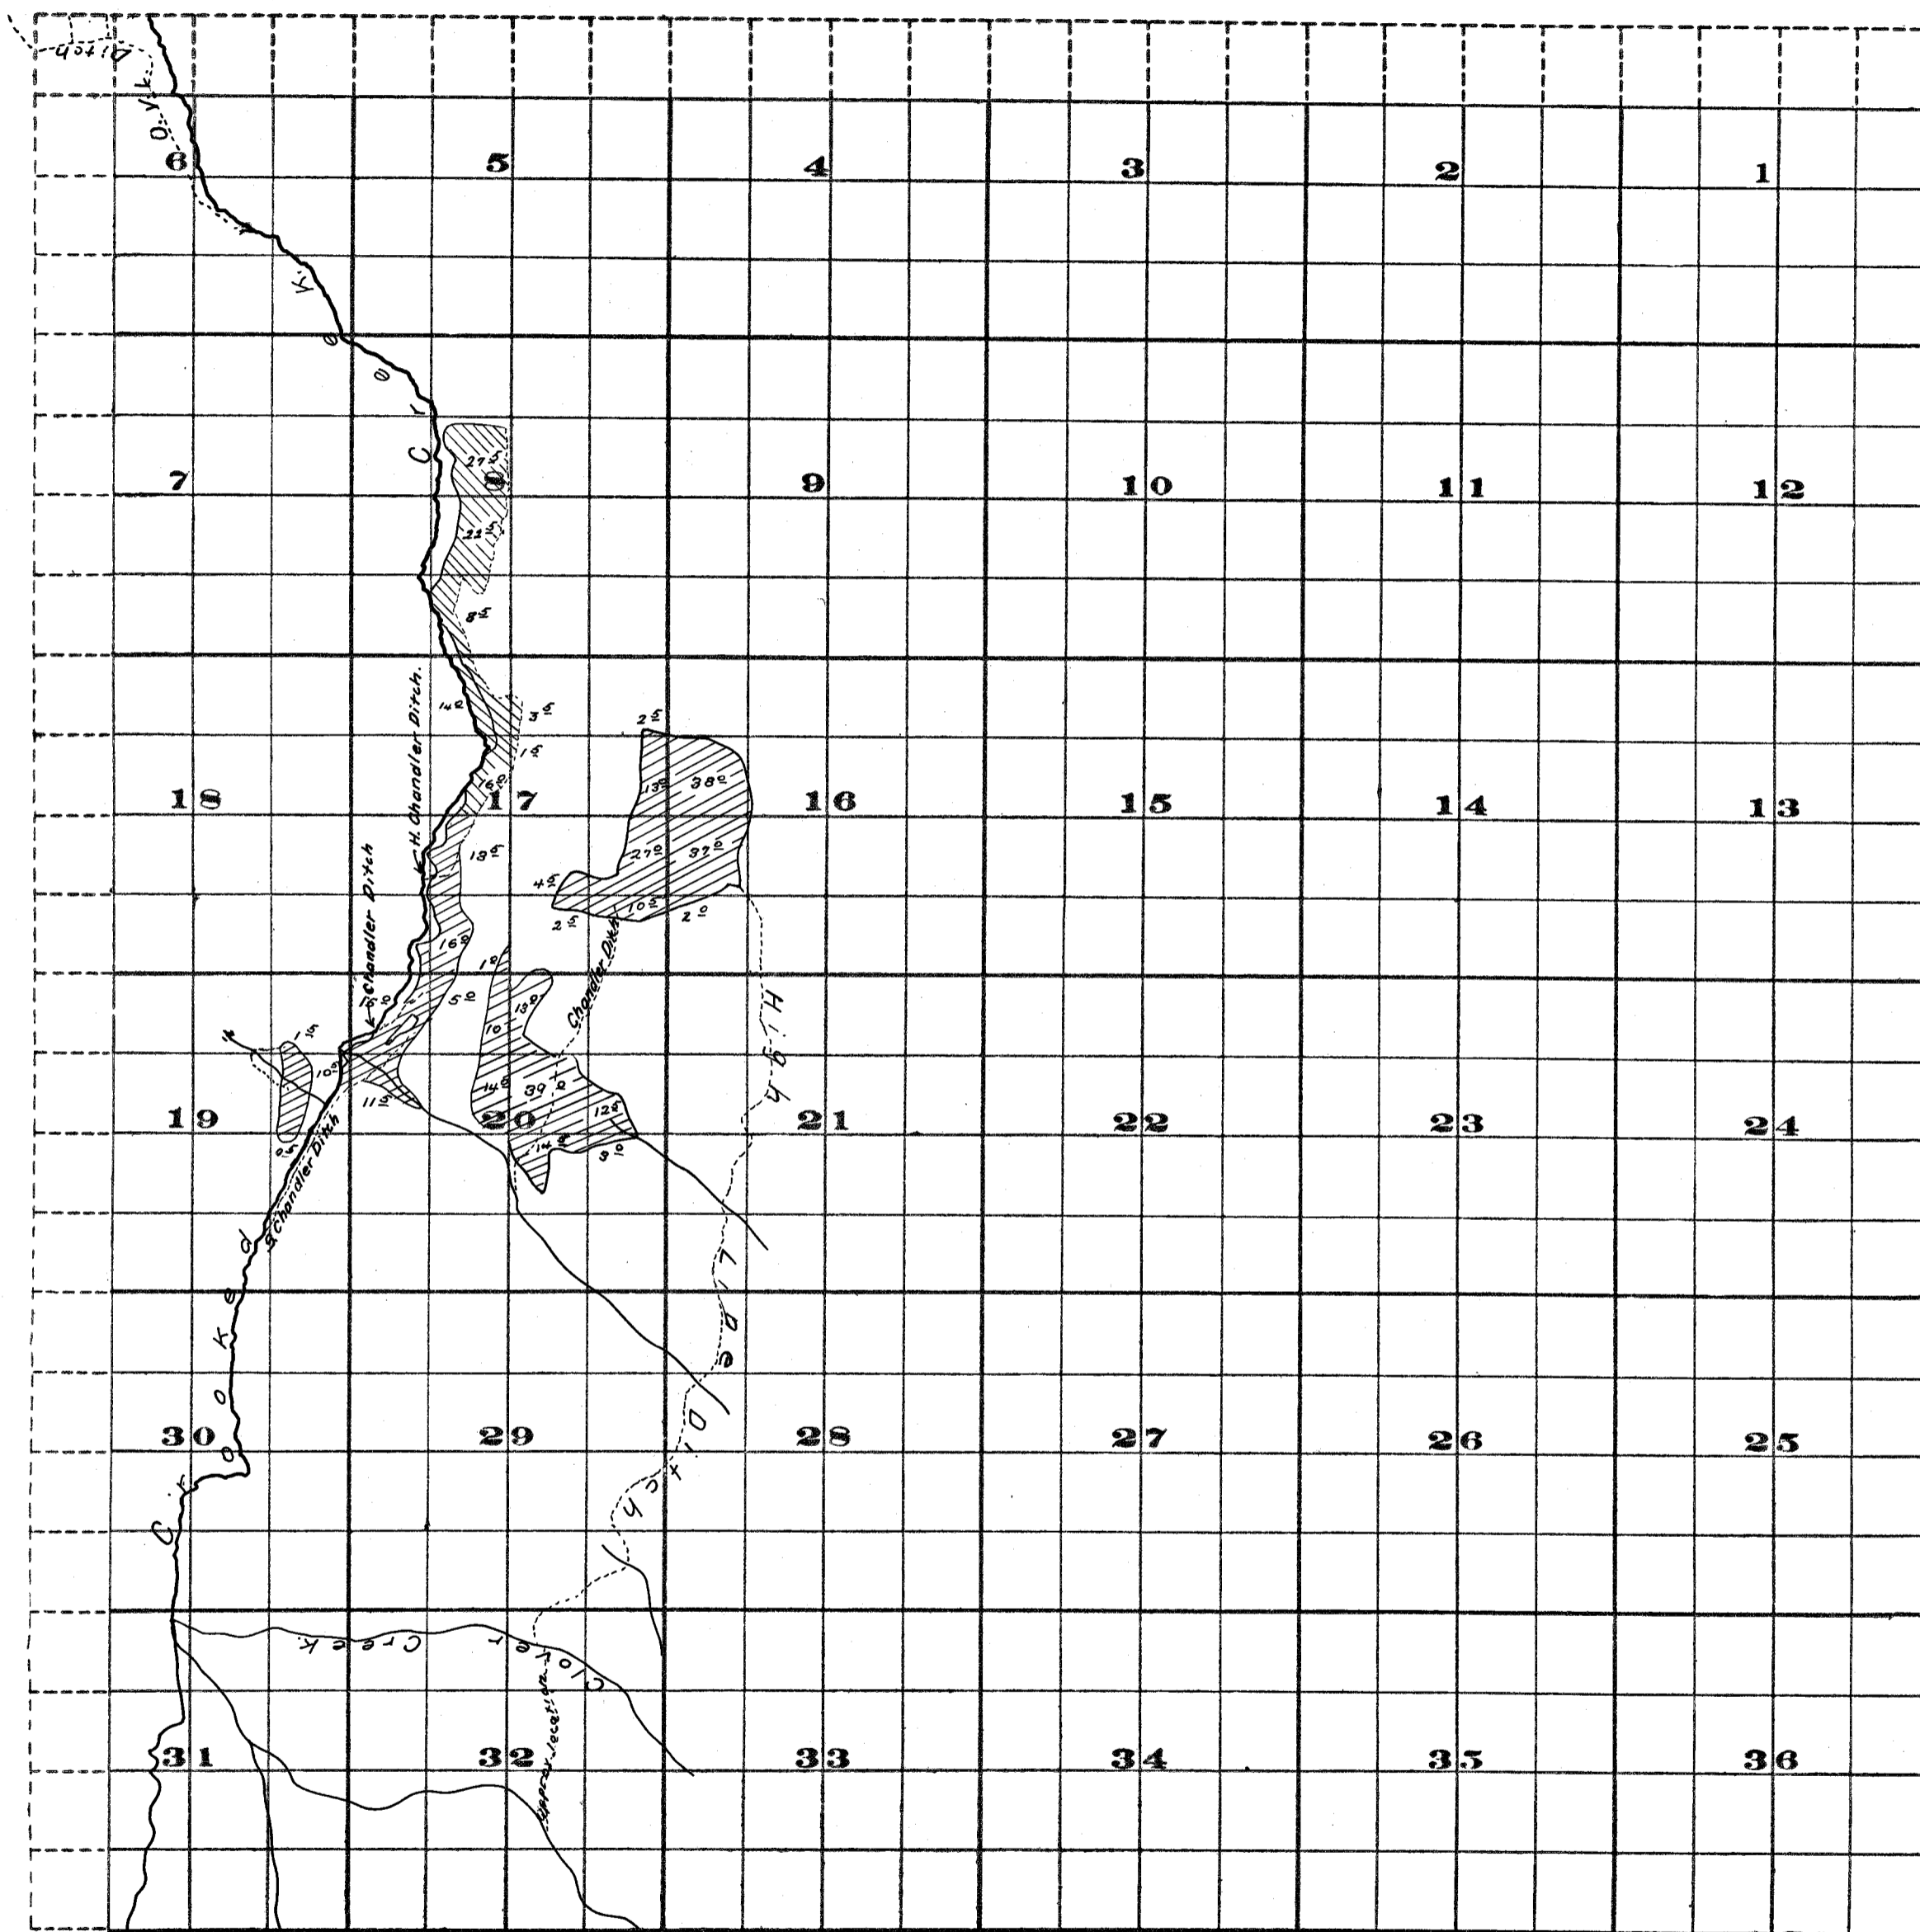

LEGEND

- Irrigated land with areas.
- Ditches.
- Streams.

Survey by Chas. E. Stricklin
Nov. 1912.

FROM OFFICE OF THE STATE ENGINEER, SALEM, OREGON

ADJUDICATION
OF
CHEWAUCAN RIVER AND TRIBUTARIES
John H. Lewis, State Engr.

T365-R, 21 E.