


T.16S.,R.6E.,W.M.

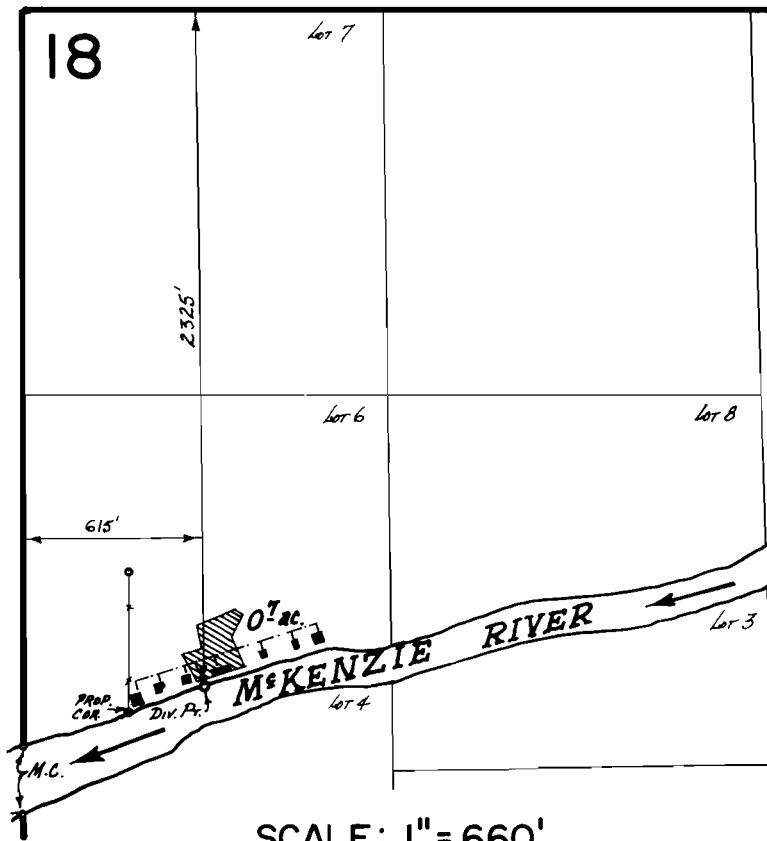

FINAL PROOF SURVEY
UNDER

Application No. 48887 Permit No. 36626
IN NAME OF

LAUGHING WATERS CONDOMINIUM

Surveyed Aug. 16 1977, by L.M. TOLL