


T. 15 S., R. 1 W., W.M.

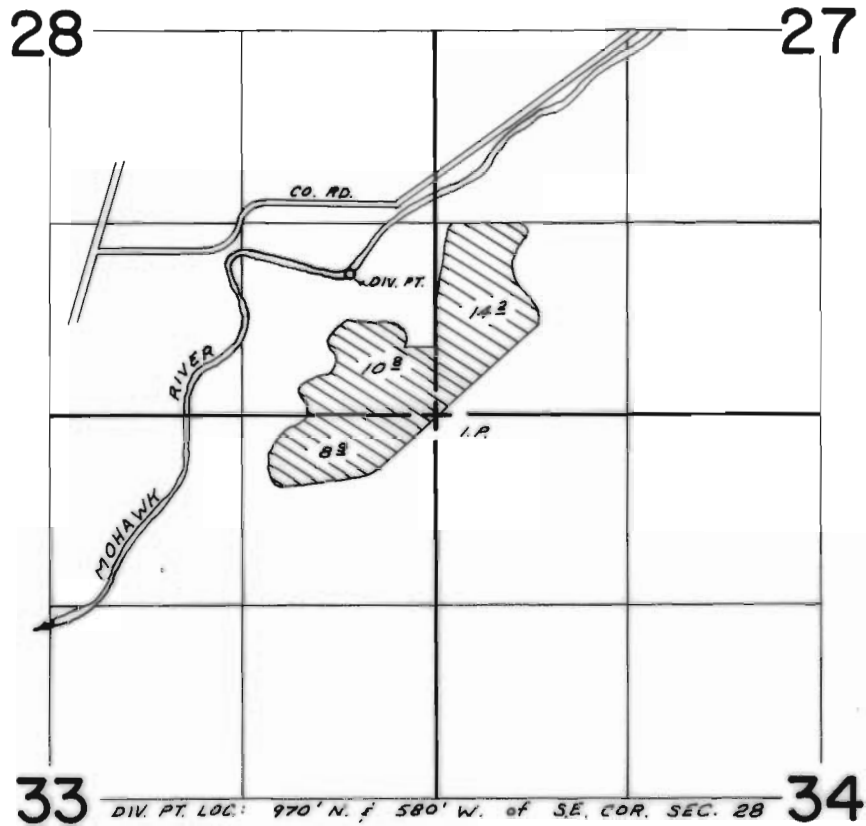

FINAL PROOF SURVEY UNDER

Application No. 49504 Permit No. 36073

IN NAME OF

Robert S. & Nancy Russell

Surveyed Oct. 27, 1976, by D.M. NORBY