


T.15S. R.1W. W.M.

SEC. 22

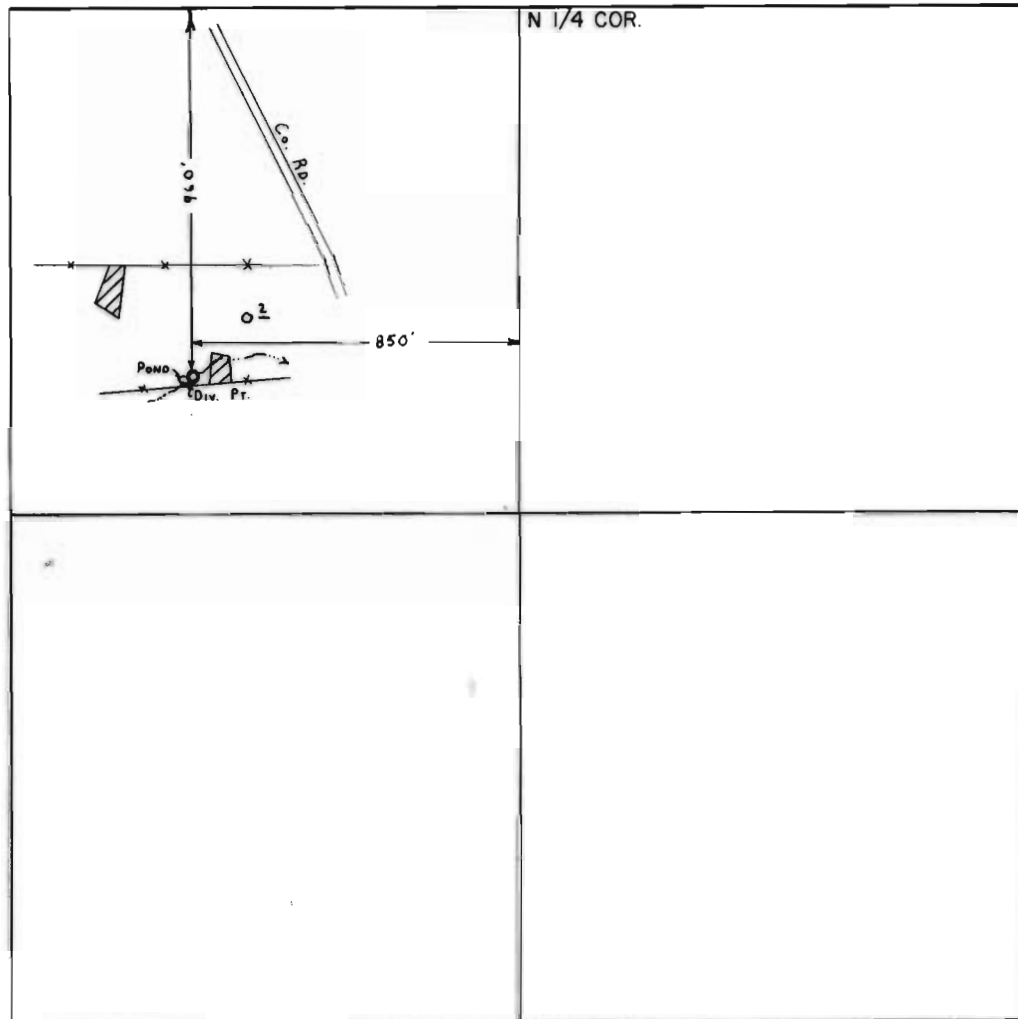

SCALE 1" = 500'

FINAL PROOF SURVEY
UNDER

Application No. 52665 Permit No. 39685
IN NAME OF

GEORGE E. WRIGHTMAN

Surveyed SEP 2 1977, by L.H. NUNN