


# T.17S. R.2W. W.M.

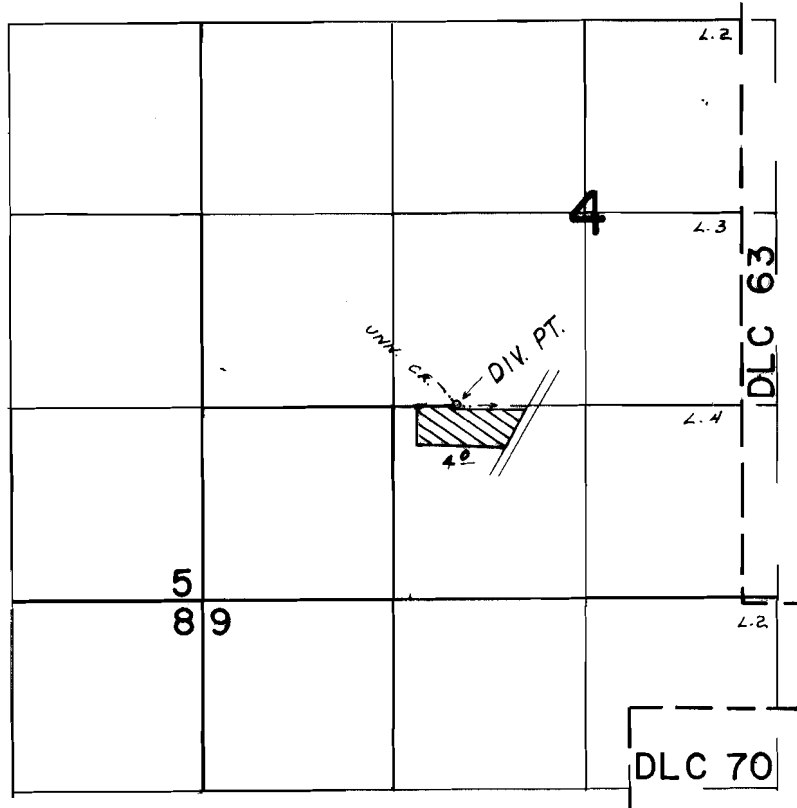

DIV. PT. LOC. 1320' N. & 1760' E. FROM SW COR. SEC. 4

## FINAL PROOF SURVEY UNDER

Application No. 53691 Permit No. 40140  
IN NAME OF

HAROLD O. & VERA M. BURLESON

Surveyed SEP. 1, 1977, by L.H. NUNN