


T.18S. R.10W., W.M.

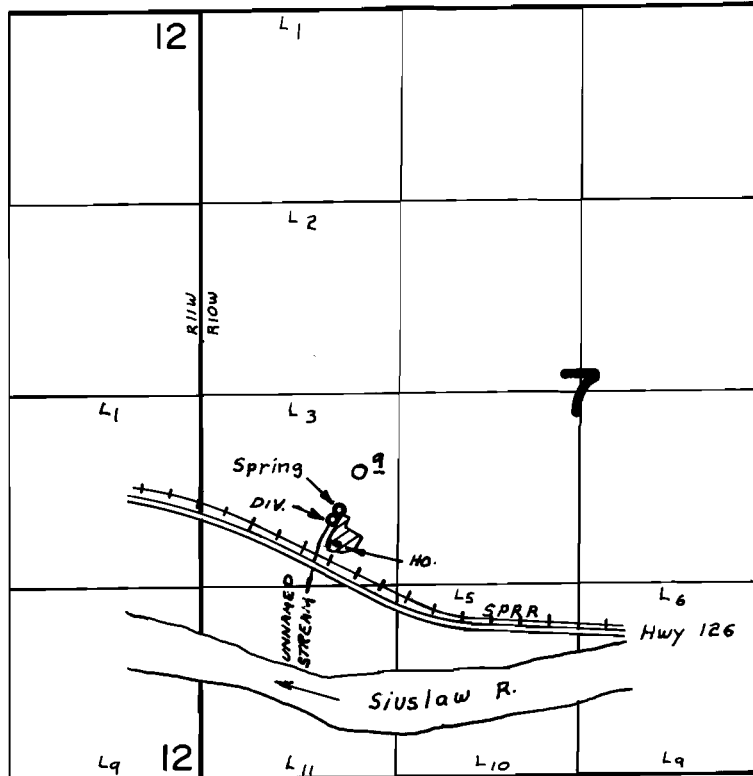

Spring Loc. 1840' N. & 950' E. From S.W. Cor. Sec. 7

FINAL PROOF SURVEY UNDER

Application No. 55233... Permit No. 41417.....
IN NAME OF

.....CHARLES & EILEEN MILLER.....

Surveyed JULY 25 1978, by C.L. HUGHES.....