


T.15 S. R. 5 & 6 W. W. M.

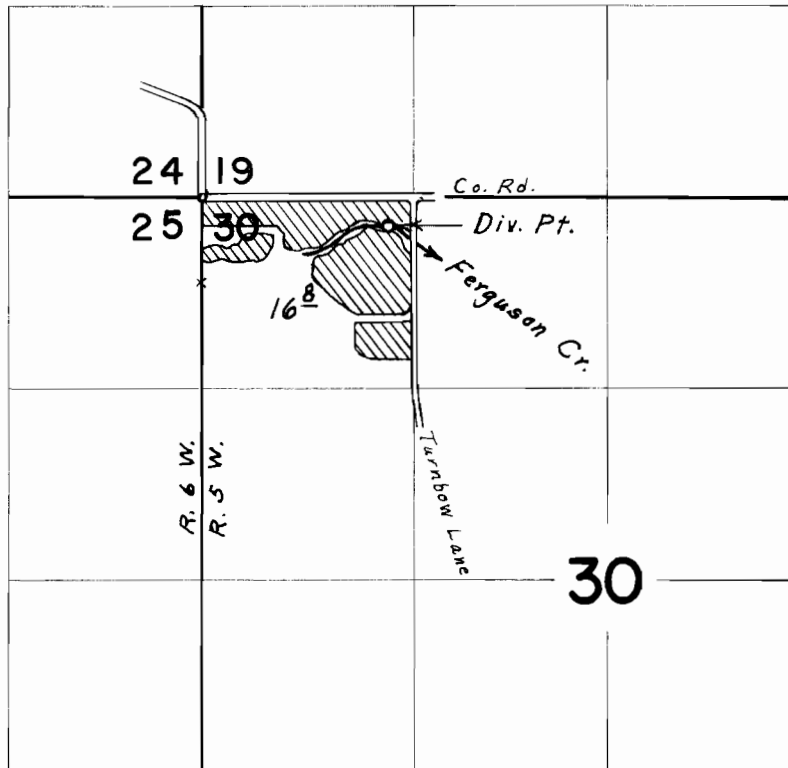

Div. Pt. located 190' S. & 1270' E. from N.W. Cor. Sec. 30

FINAL PROOF SURVEY
UNDER

Application No. 42477 Permit No. 31767
IN NAME OF

FRED J. BLAKE


Surveyed Aug. 28, 1970, by L. E. Gould

RECEIVED

AUG 19 1977

WATER RESOURCES DEPT
SALEM, OREGON

T.15 S. R.5 & 6 W. W.M.

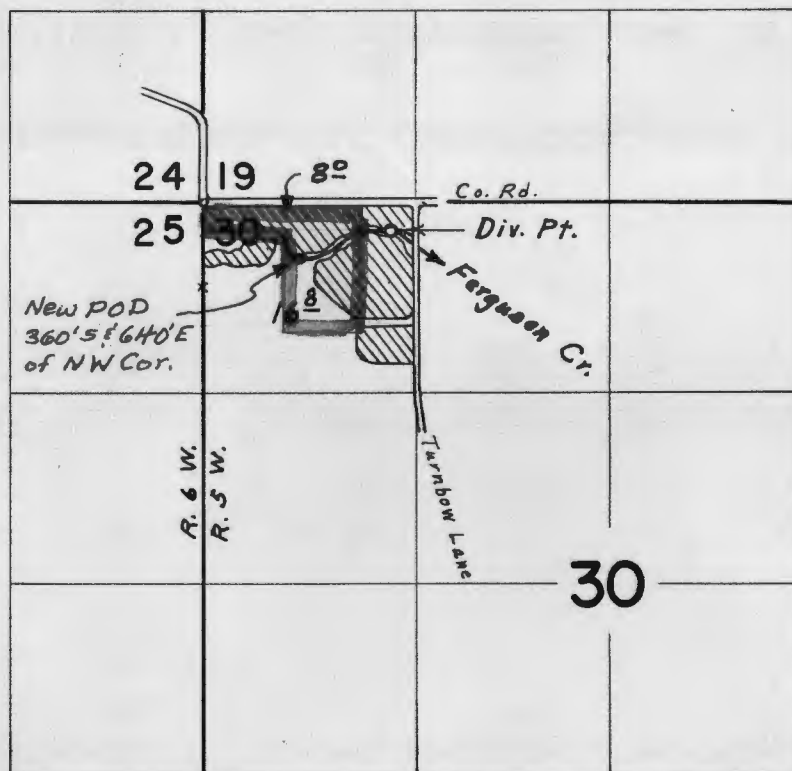

Div. Pt. located 190' S. & 1270' E. from N.W. Cor. Sec. 30

FINAL PROOF SURVEY
UNDER

Application No. 42477 Permit No. 31767
IN NAME OF

FRED J. BLAKE

Surveyed Aug. 28, 1970, by L. E. Gould