


T.IOS. R.IOW. W.M.

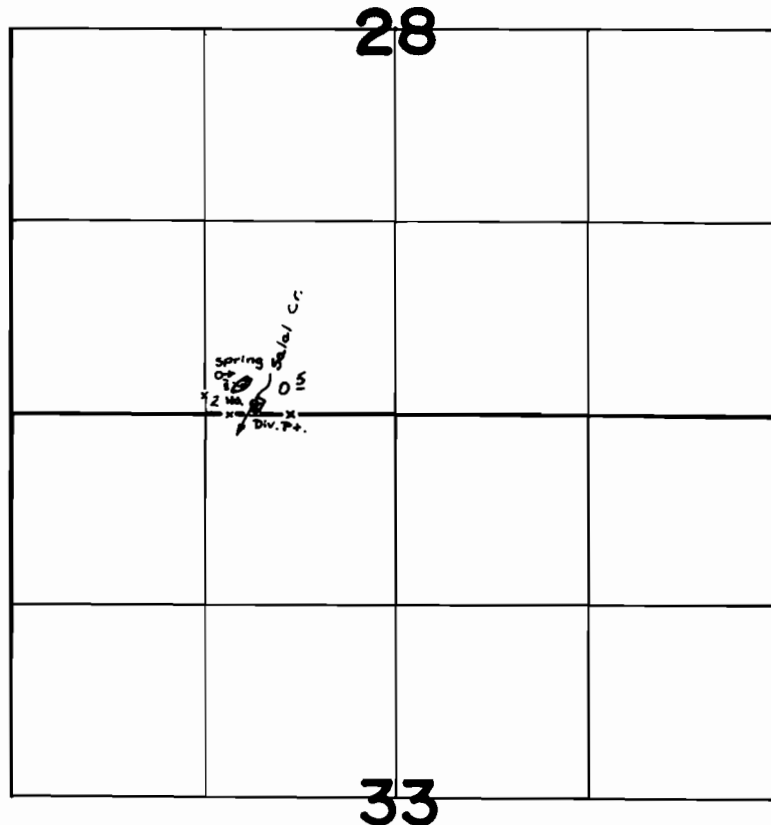

Div. Pt. Located: $75' N \frac{1}{2} 325' E$ of Spring Located: $275' N \frac{1}{2} 100' E$
both from the SW cor. of SE $\frac{1}{4}$ SW $\frac{1}{4}$ Sec. 28

FINAL PROOF SURVEY
UNDER

Application No. **48857** Permit No. **36610**
IN NAME OF
Estate of
ESTHER M. and FRANK W. CARSON

Surveyed OCT. 24, 1977, by J.S. DONALDSON