


T.IOS., R.I.W. & I.E., W.M.

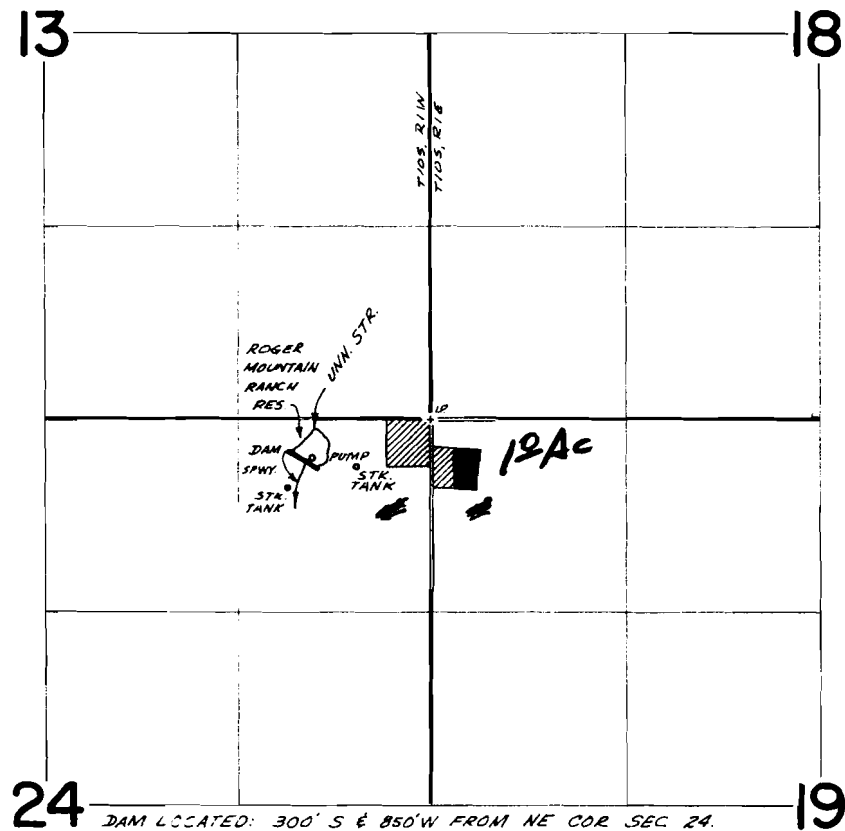

FINAL PROOF SURVEY UNDER

~~R-47105~~ ~~R-5596~~
Application No. ~~47105~~ Permit No. ~~34945~~
IN NAME OF

H. O. LIVENGOOD

Surveyed May 22, 1974, by D. Norby

Application No. 54369
Permit No. 40748

RECEIVED
JUL 1 1976
WATER RESOURCES DEPT.
