


T.18S., R.47E., W.M.

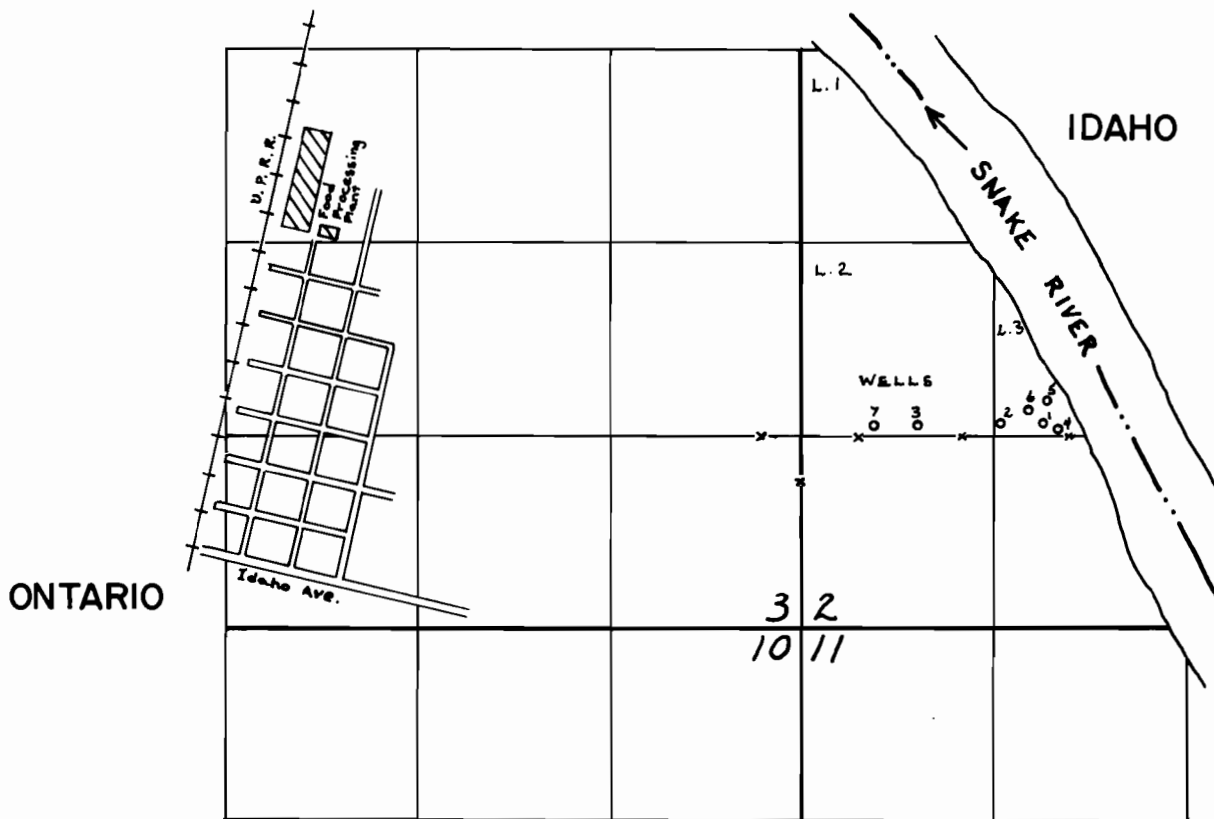

Wells Located: 1- 80' N $\frac{1}{2}$ 1660' E; 2- 80' N $\frac{1}{2}$ 1370' E; 3- 60' N $\frac{1}{2}$ 800' E; 4- 50' N $\frac{1}{2}$ 1760' E;
 5- 250' N $\frac{1}{2}$ 1680' E; 6- 180' N $\frac{1}{2}$ 1560' E; 7- 60' N $\frac{1}{2}$ 500' E all from the
 SW cor. of Lot 2 (NW $\frac{1}{4}$ SW $\frac{1}{4}$) Sec. 2; being within: wells 1, 2, 4, 5, 6
 Lot 3 (NE $\frac{1}{4}$ SW $\frac{1}{4}$), wells 3, 7 Lot 2 (NW $\frac{1}{4}$ SW $\frac{1}{4}$) Sec 2

FINAL PROOF SURVEY UNDER

Application No. G-6482 Permit No. G-6028
 IN NAME OF

ORE-IDA FOODS, INC.

Surveyed OCTOBER 19 1977, by J. S. DONALDSON