


T.18 S., R. 45 E., W.M.

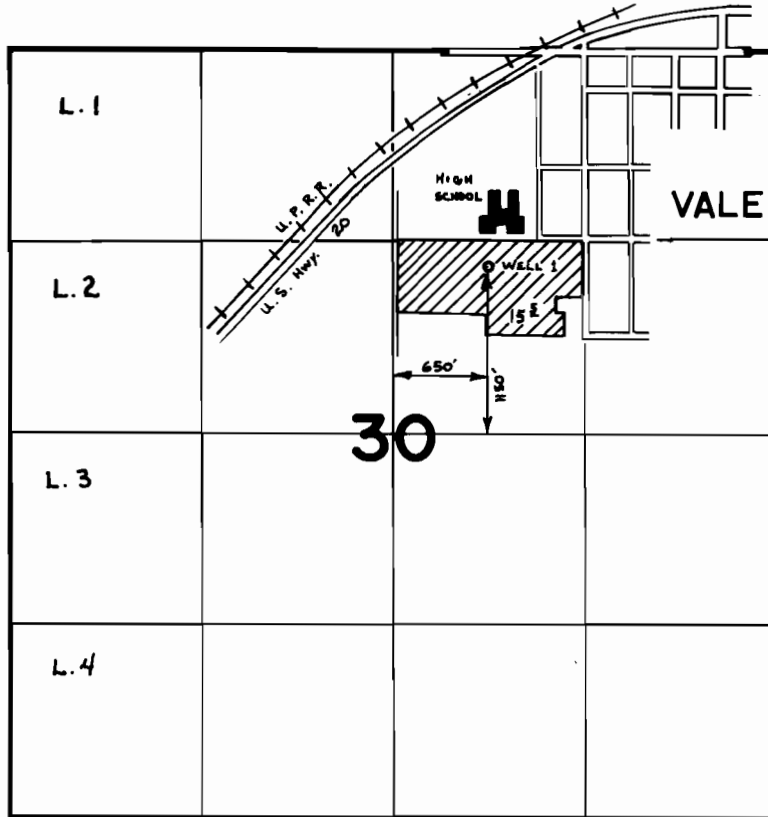

FINAL PROOF SURVEY UNDER

Application No. ~~G-6944~~ Permit No. G-6459
IN NAME OF

VALE UNION HIGH SCHOOL DISTRICT U-3

Surveyed OCT. 17, 1977, by J.S. DONALDSON