


T. 8S. R. 2W. W.M.

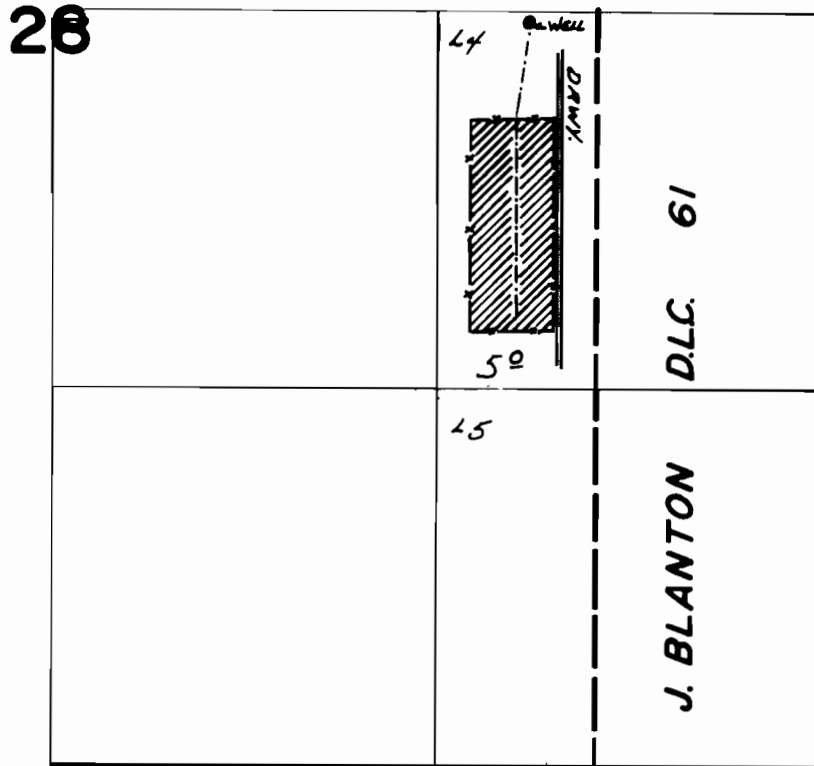

Well Loc. - 40' S of 1000' W From E/W Cor. Sec. 28

Scale 1" = 660'

FINAL PROOF SURVEY
UNDER

Application No. G-6154 ... Permit No. G-5840
IN NAME OF

JOSEPH B. EMMONS

Surveyed June 2, 1977, by D. NORBY