


T.5S. R.2W., W.M.

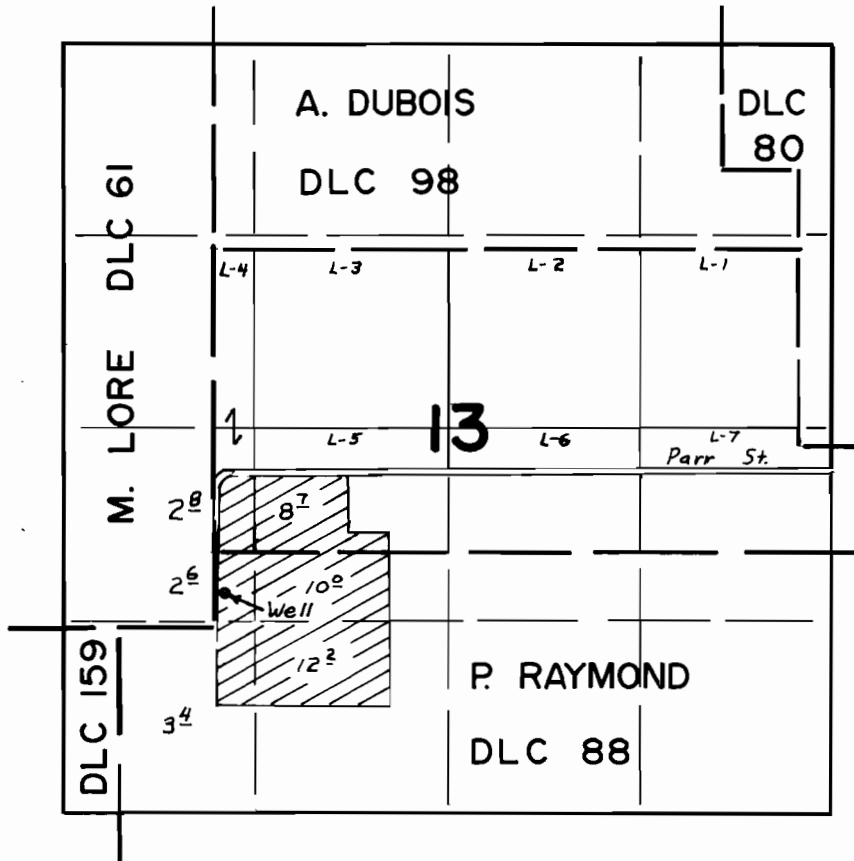

Well Loc. 230' N. & 70' E. From S.E. Cor. D.L.C. 61

FINAL PROOF SURVEY UNDER

Application No. G-6949. Permit No. G-6464.
IN NAME OF

KARNILY & AGAFIA KALUGIN

Surveyed SEPT. 8. 1977, by B.R. SUND