


T.9S. R.2W., W.M.

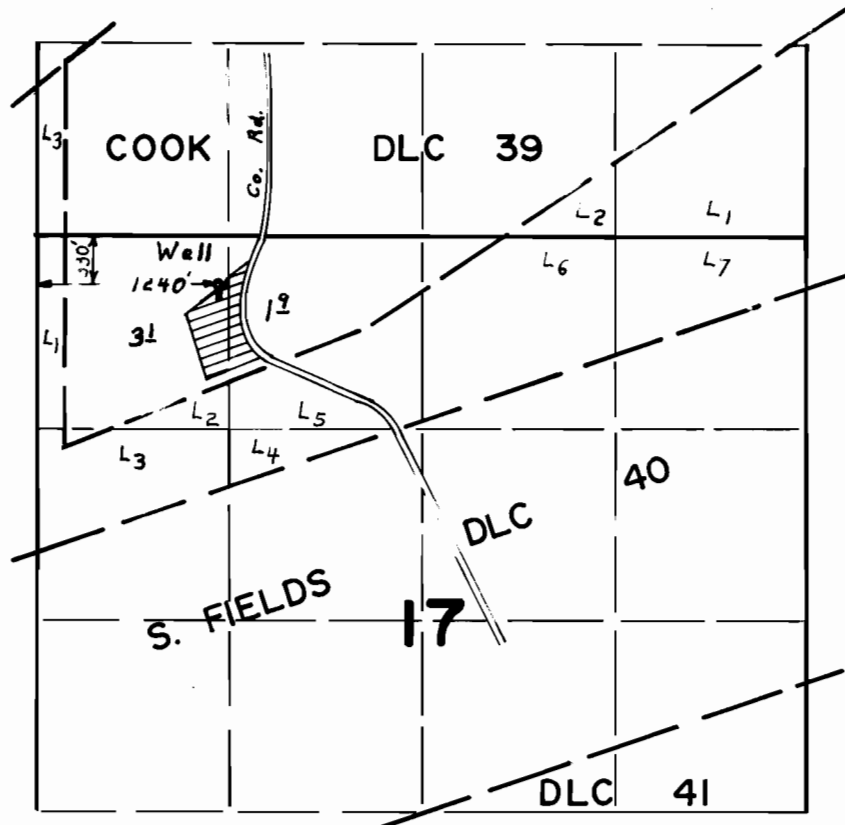

FINAL PROOF SURVEY
UNDER

Application No. G-7199... Permit No. G-6629.
IN NAME OF

.....JOSEPH L. HARTER.....

Surveyed SEP. 15... 1977, by B.R. SUND.....