


# T.7S.,R.1E.,W.M.

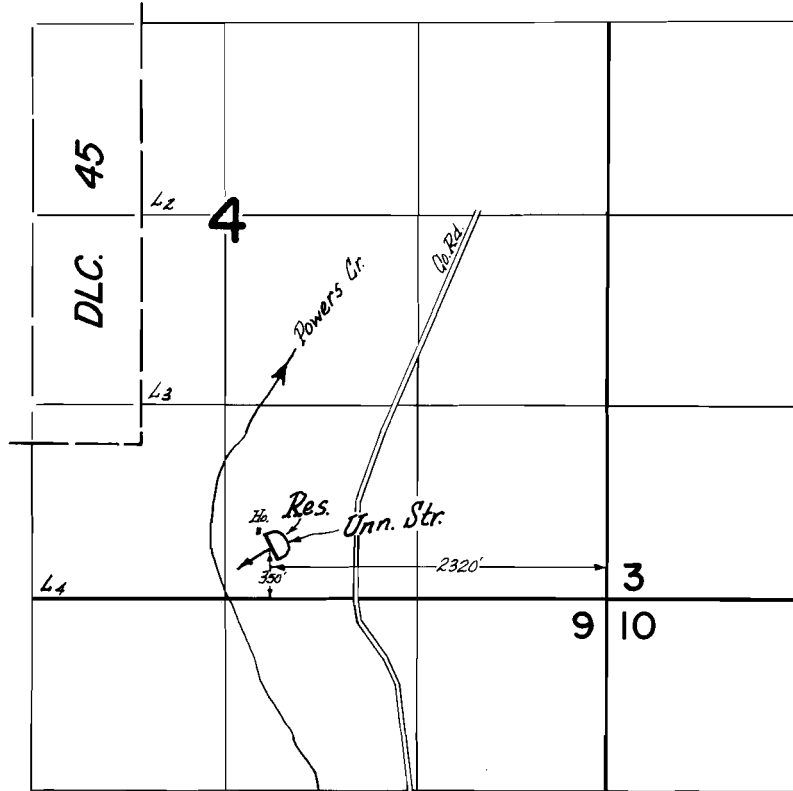

## FINAL PROOF SURVEY UNDER

R-47609                      R-5630  
Application No. 47610    Permit No. 35118  
IN NAME OF

ROBERT E. & MOZELLA A. RUBOTTOM

Surveyed *Sept. 8* 19*77*, by *R. G. Mucken*