


T.9S., R.4W., W.M.

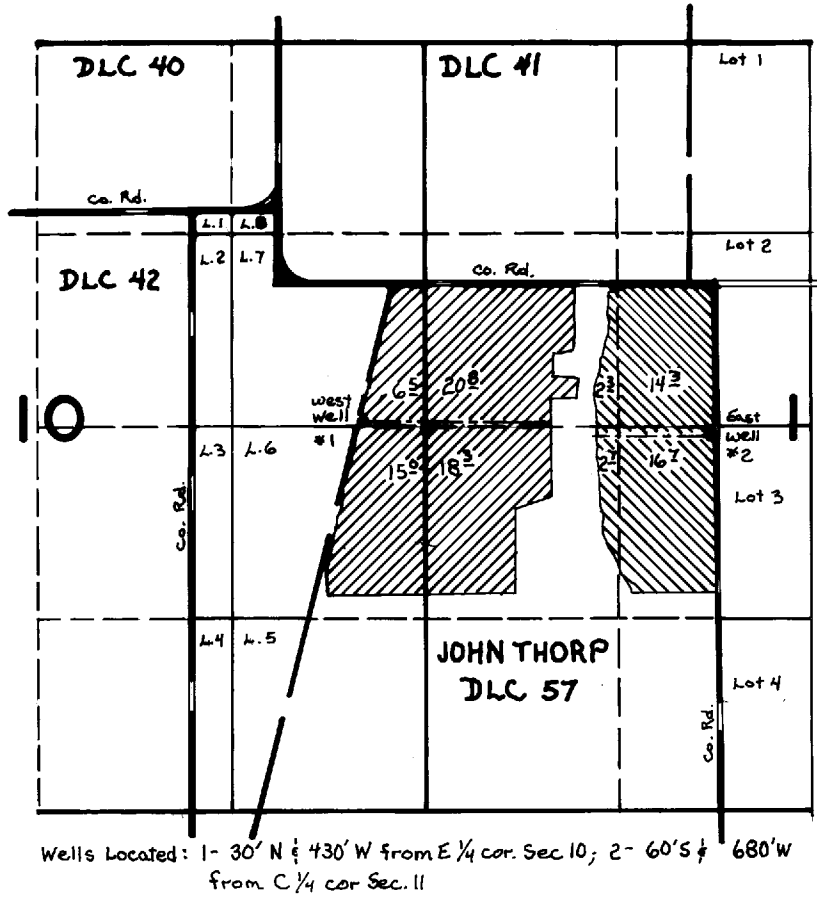

FINAL PROOF SURVEY UNDER

Application No. G-6037 Permit No. G-5717
IN NAME OF

DONALD R. COBINE

Surveyed MAY 21 1976, by C.R. KING