


T.6S. R.7W. W.M.

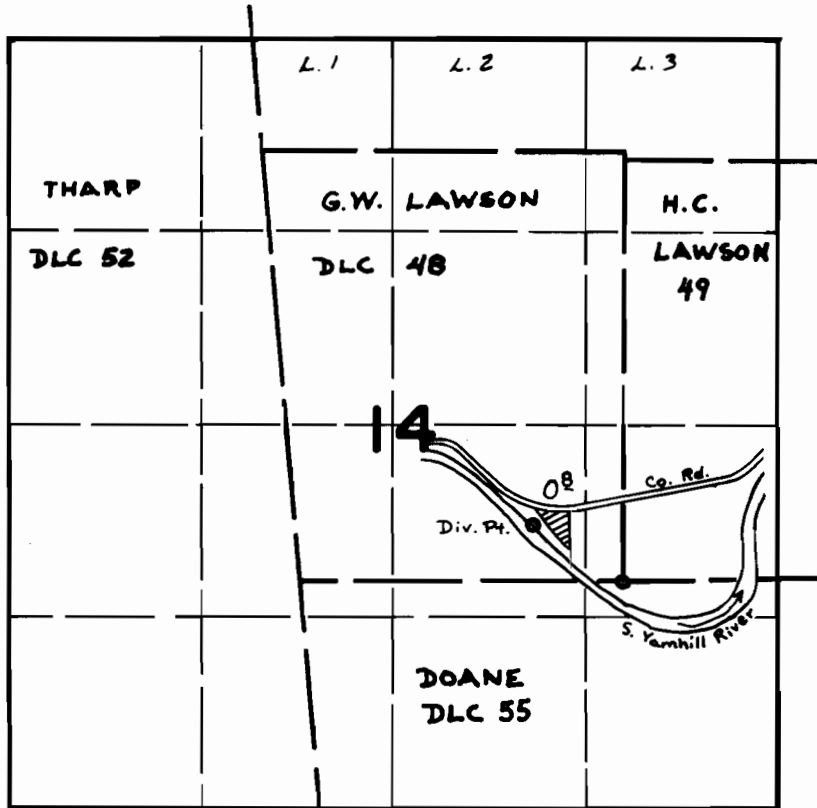

Div. Pt. Located: 375' N & 625' W from SE cor. G.W. Lawson DLC 48

FINAL PROOF SURVEY UNDER

Application No. 49774 Permit No. 36947
IN NAME OF

RAY B. KESTERSON

Surveyed SEPT. 16. 1977. by D. NORBY