


T.8S., R.6W., W.M.

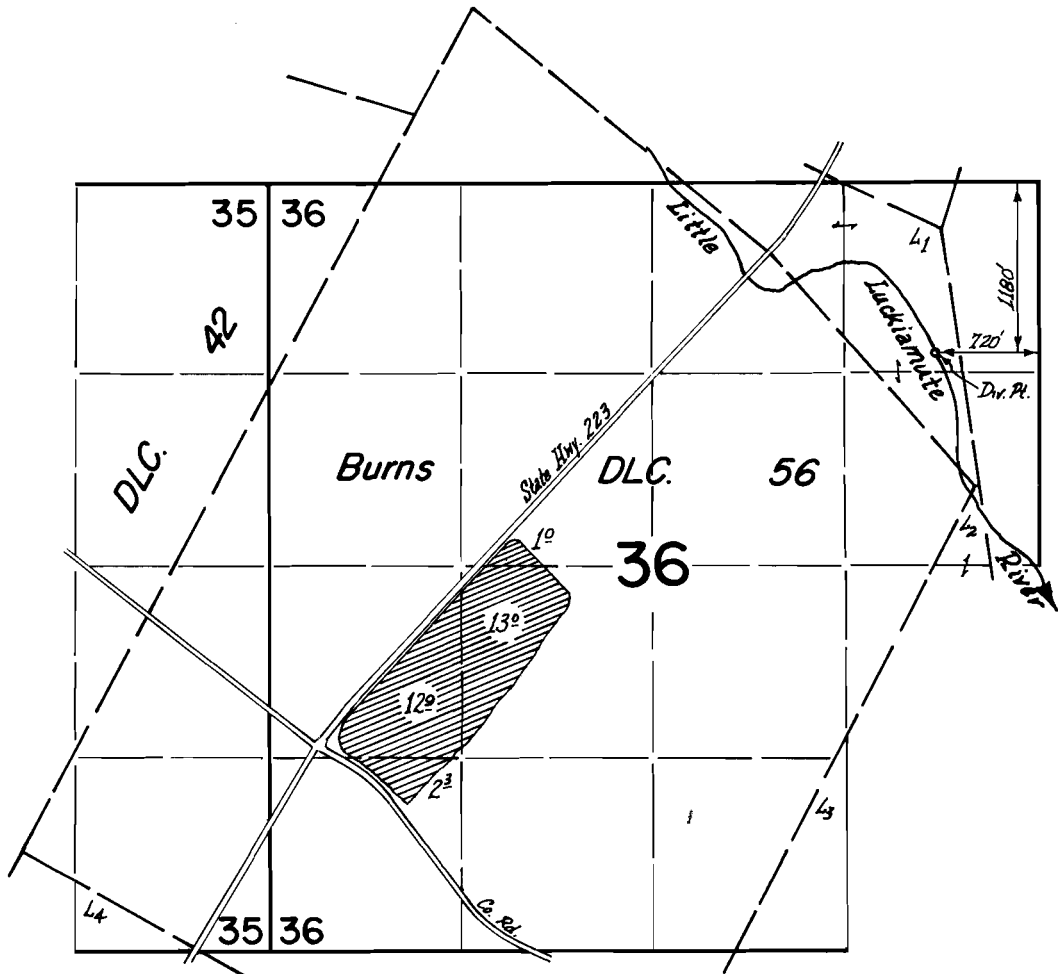

FINAL PROOF SURVEY UNDER

Application No. 53198 Permit No. 39475
IN NAME OF

J. L. HENDRICKSON

Surveyed July 7 1977, by L.M. Toll