


PROPOSED PLACE OF USE and POINT OF DIVERSION

T.9S.R.5W.W.M.

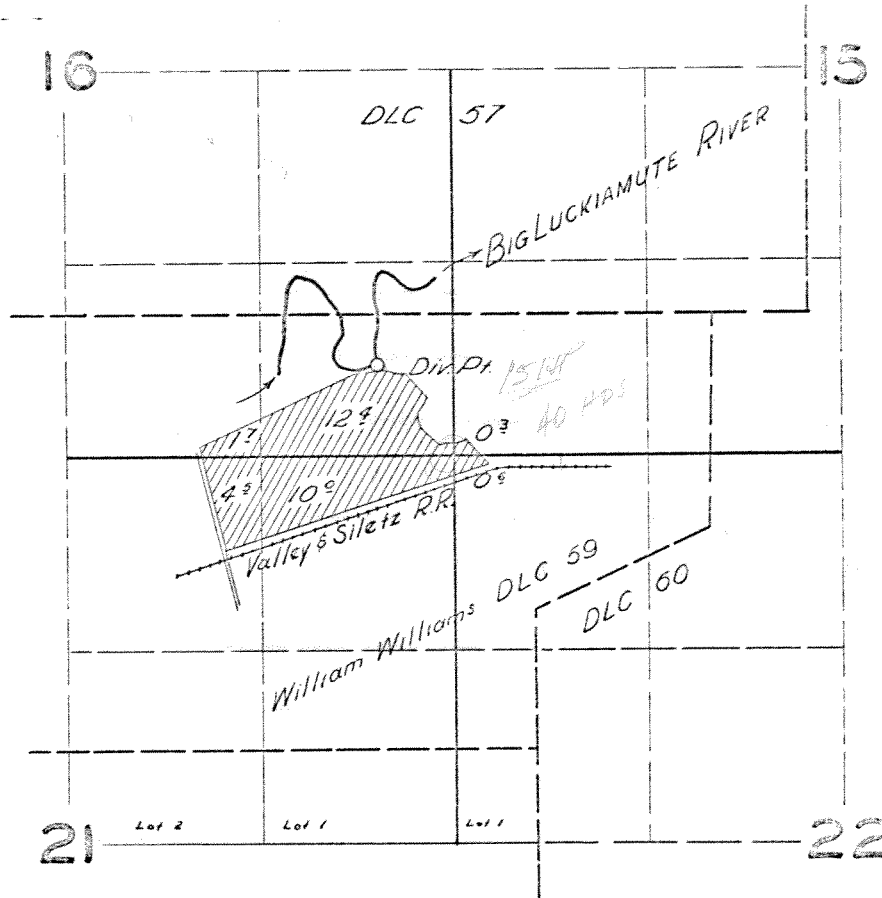

FINAL PROOF SURVEY
UNDER

Application No. 24601 Permit No. 19649
IN NAME OF

FRED AUER & SONS

Surveyed 28 Mar. 1957, by C. H. Whittier