


T.3S., R.10W., W.M.

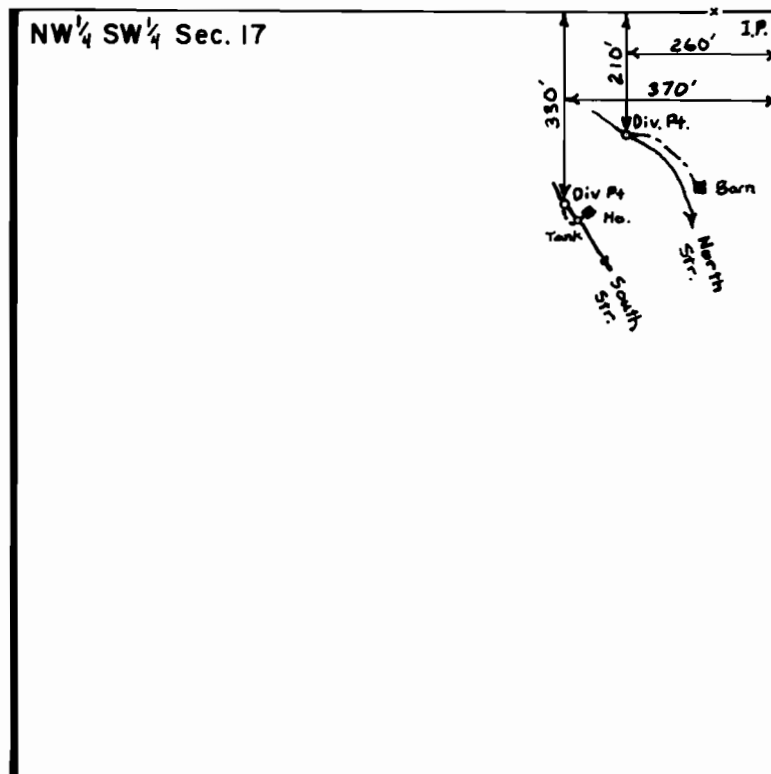

SCALE: 1" = 330'

FINAL PROOF SURVEY
UNDER

Application No. 51887 Permit No. 39154
IN NAME OF

D.V. DERRICK

Surveyed JUNE 24 1976, by D. NORBY