


T.3N.R.10W.W.M.

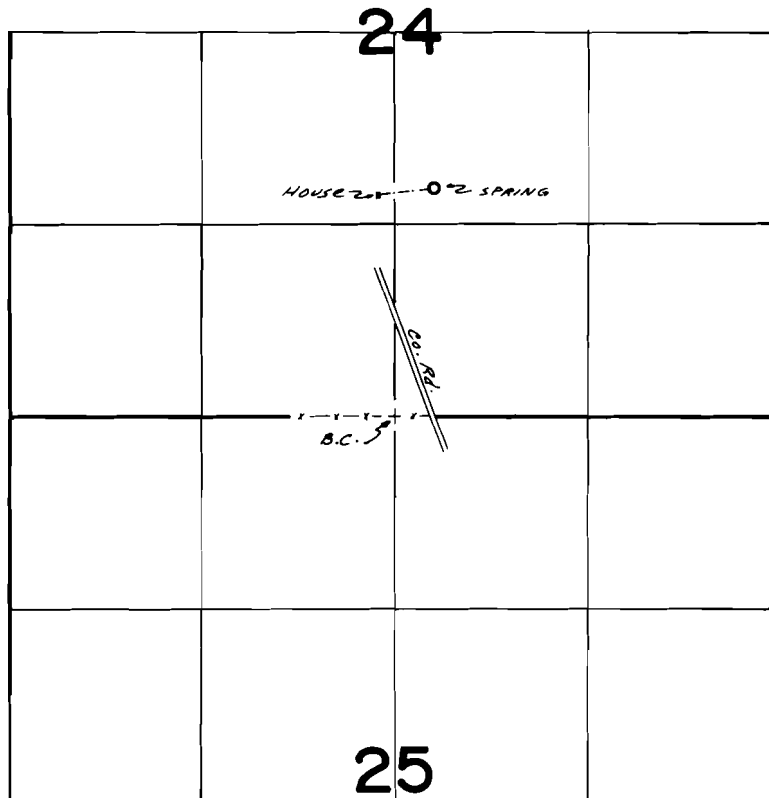

SPRING LOC. 1580' N & 280' E From S 1/4 Cor. Sec. 24

FINAL PROOF SURVEY
UNDER

Application No. 54384 Permit No. 40757
IN NAME OF

THEODORE R. & VIRGINIA A. KAPPEL

Surveyed Sept. 29 1977, by S.C. BROWN