


T.1S. R.3W., W.M.

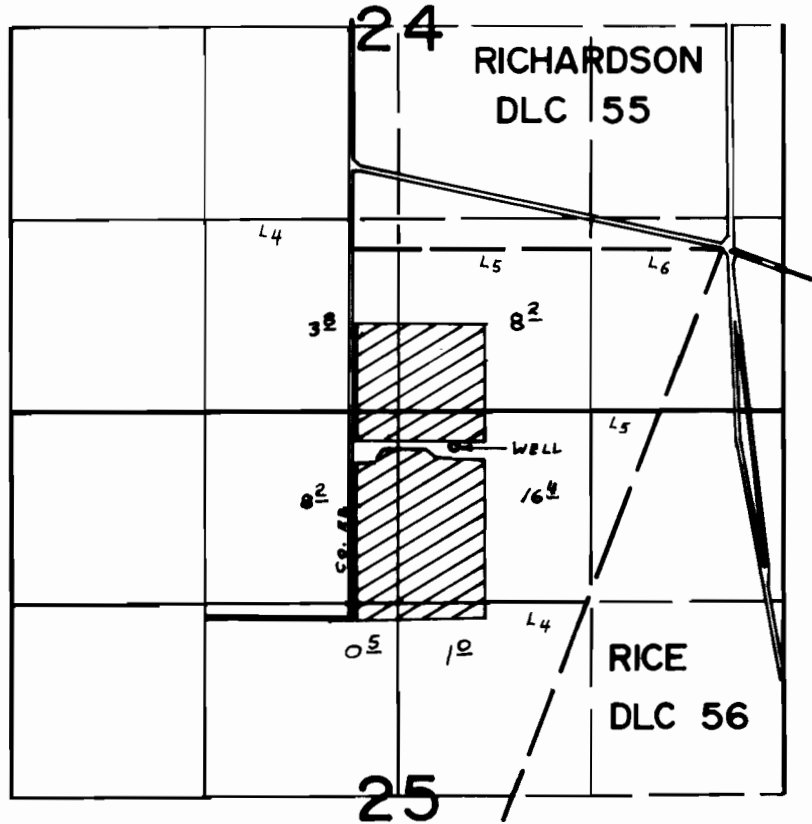

WELL LOC. 1830' N. & 1380' E. FROM N.W. COR. RICE DLC 56

FINAL PROOF SURVEY UNDER

Application No. G-6105... Permit No. G-5783...
IN NAME OF

.....ALBERT.....CALVIN.....RIEDWEG.....

Surveyed MAY 4, 1977, by D.M. NORBY.....