


T. 1N. R. 4W. W.M.

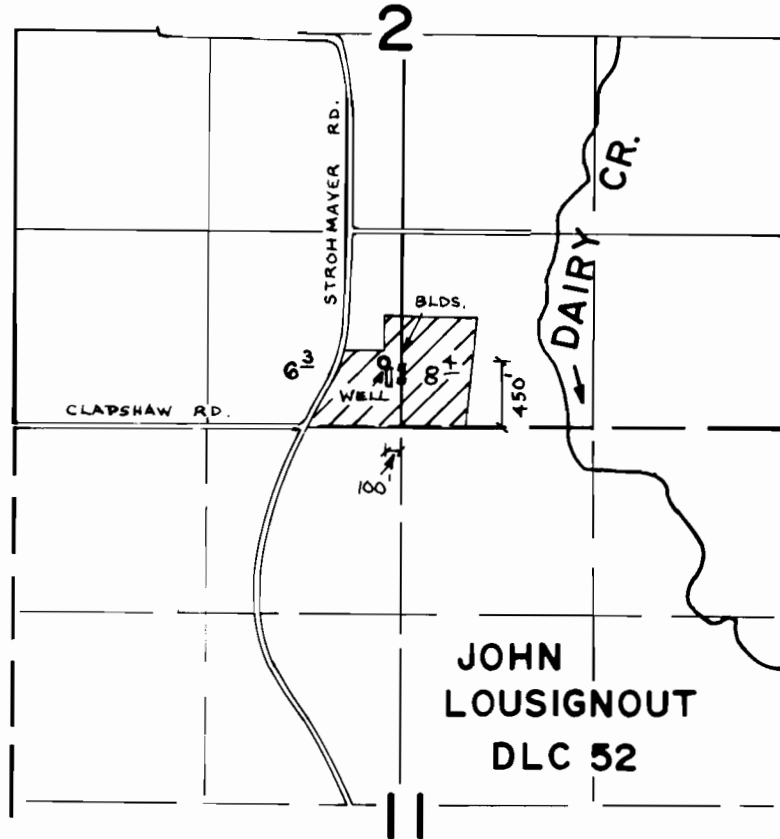

**FINAL PROOF SURVEY**  
UNDER

Application No. G-6245 Permit No. G-5889  
IN NAME OF

MILDRED W. WARREN

Surveyed May 18, 1976, by R. G. Mucken