


T. 2N. R. 2W. W.M.

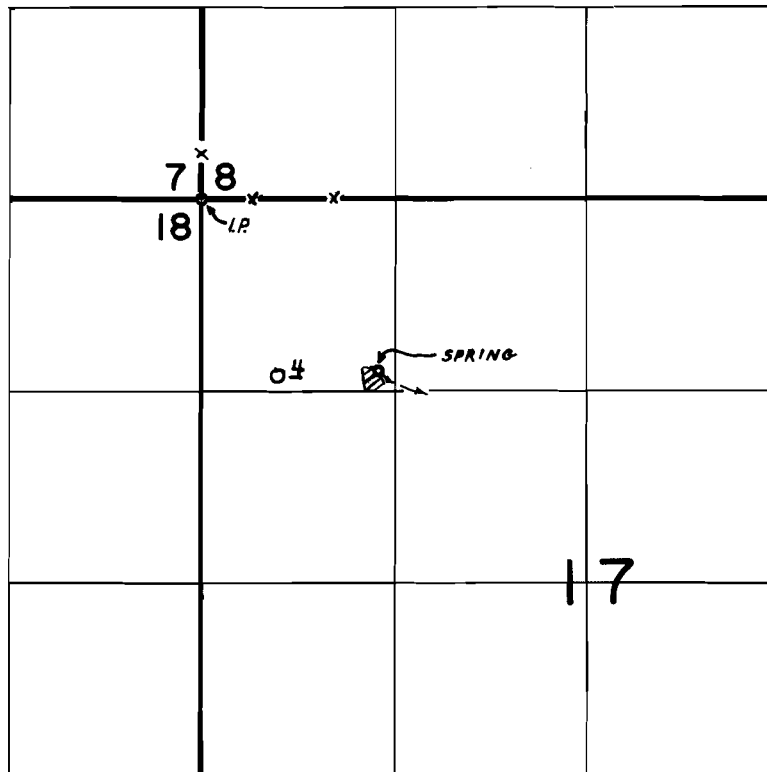

SPRING LOC. 1180'S. & 1230'E. FROM N.W. COR. SEC. 17

FINAL PROOF SURVEY
UNDER

Application No. 48315 Permit No. 36280
IN NAME OF

CARL R. TANNOCK

Surveyed NOV. 10., 1977, by R.G. MUCKEN