


T.2S., R.5W., W.M.

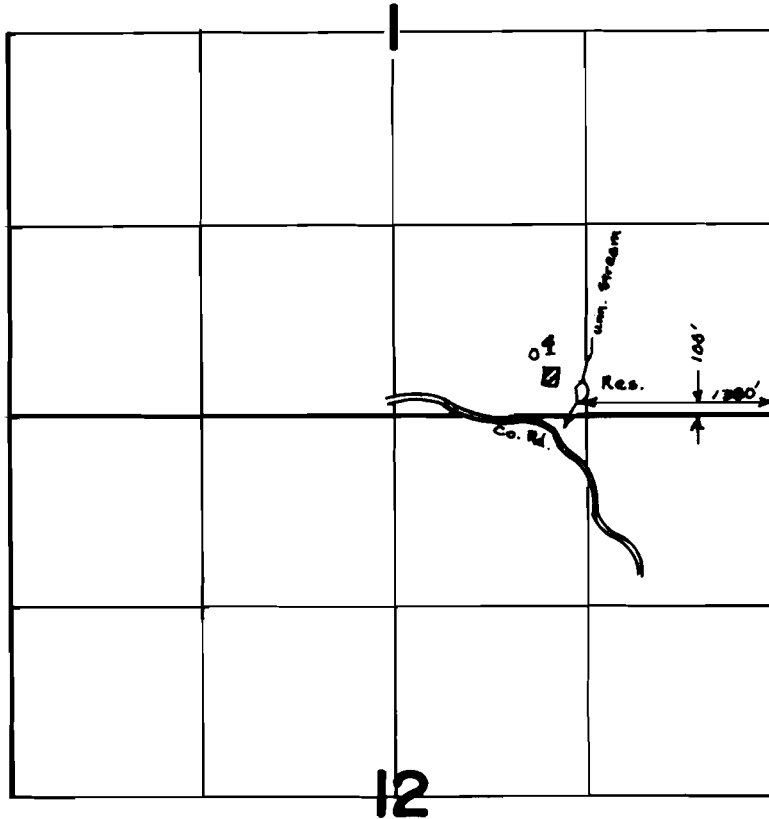

12

FINAL PROOF SURVEY
UNDER

53424 39621
Application No. R-53726 Permit No. R-6374
IN NAME OF

ROBERT W. FORD

Surveyed AUG. 4 1976, by L. NUNN