


T.14S.,R.8W.,W.M.

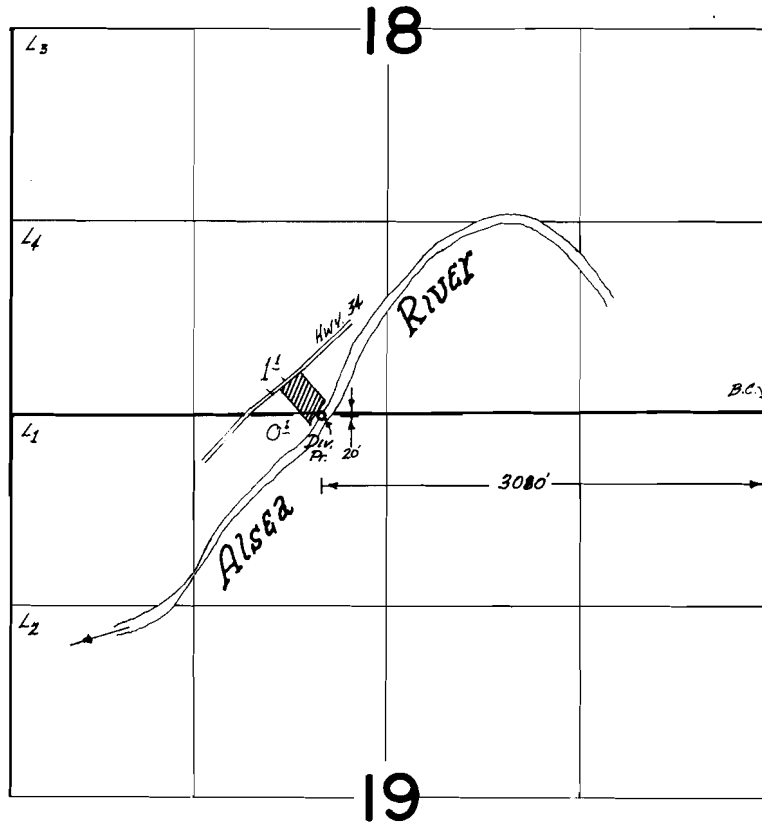

FINAL PROOF SURVEY
UNDER

Application No. 50458 Permit No. 38111
IN NAME OF

HOMER E. YOUNG

Surveyed Apr. 29 1977, by L.M. TOLL