


T.3S.,R.5E.,W.M.

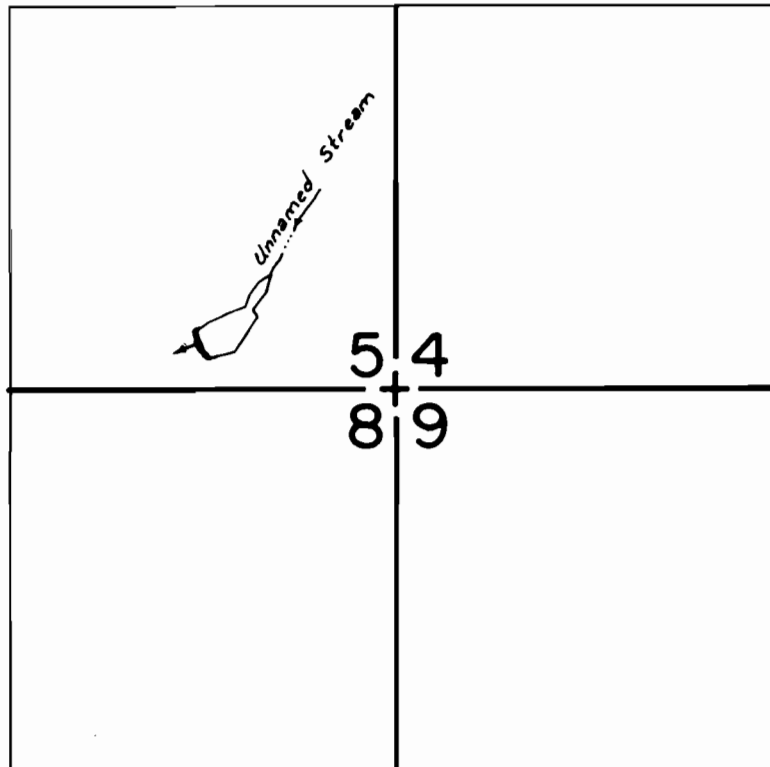

DIV. LOC: 160' N & 680' W. FROM S.E. COR. SEC. 5

SCALE 1" = 660'

FINAL PROOF SURVEY
UNDER

Application No. R-51209 Permit No. R-6228
IN NAME OF

Allan D. Fleshman

Surveyed Aug 4, 1977 by dC Brown

PTS-1977-L