


T.2S.R.1E.W.M.

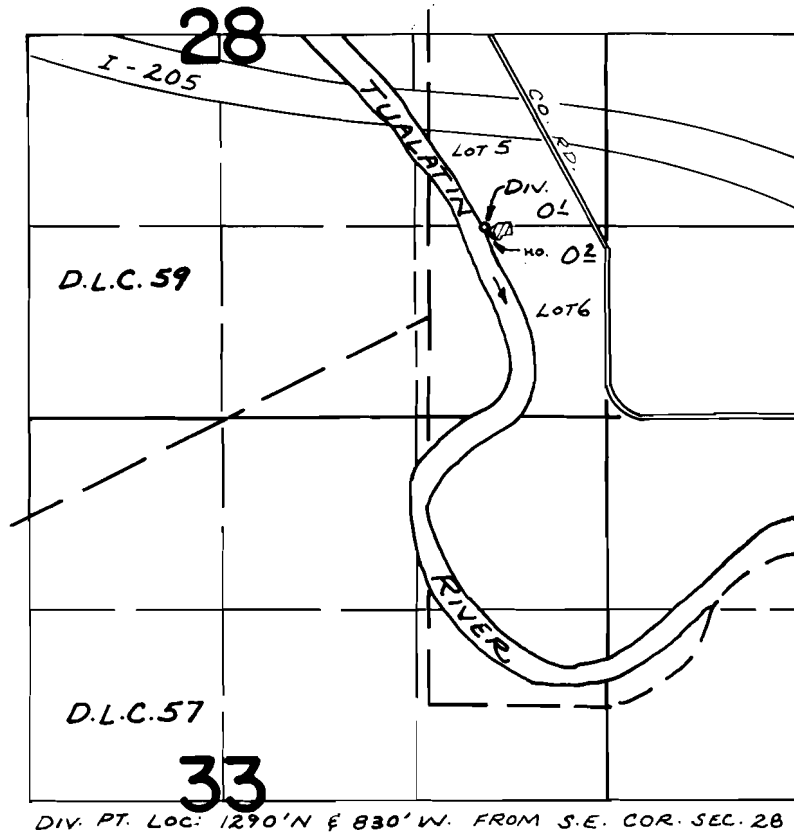

FINAL PROOF SURVEY UNDER

Application No. 54101 Permit No. 40503
IN NAME OF

HENRY F. & JULIE F. ANDERSON

Surveyed JULY 6, 1977, by R. MUCKEN