


T.5&6S. R.1E.W.M.

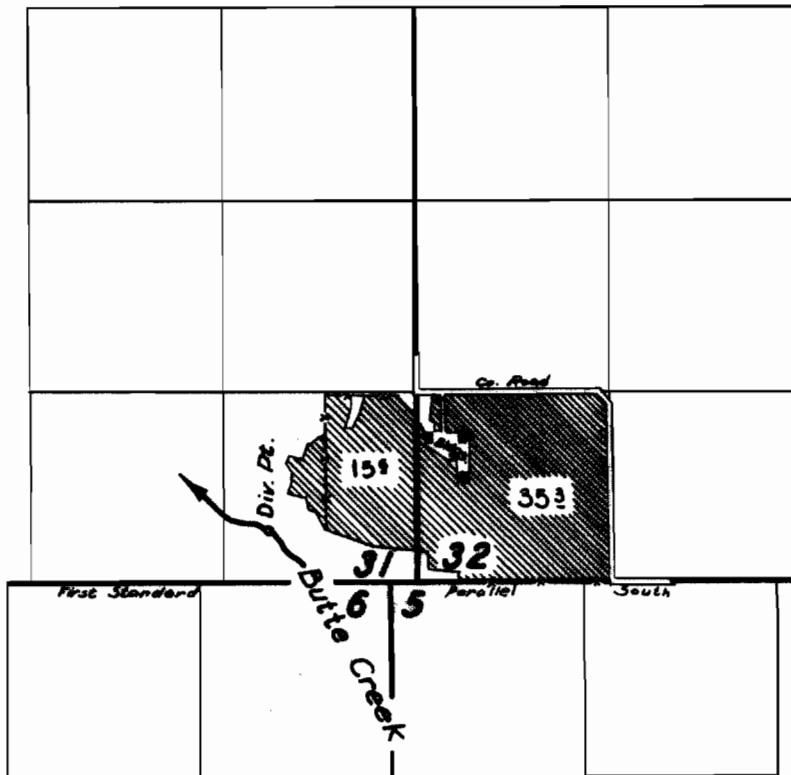

FINAL PROOF SURVEY
UNDER

Application No. 29350... Permit No. 23129...
IN NAME OF

WILFRED B. & FRED A. HATCHER

Surveyed 8 Oct. 1958, by C.O. Bartels...