


# T. 5 & 6 S. R. 1 E. W. M.

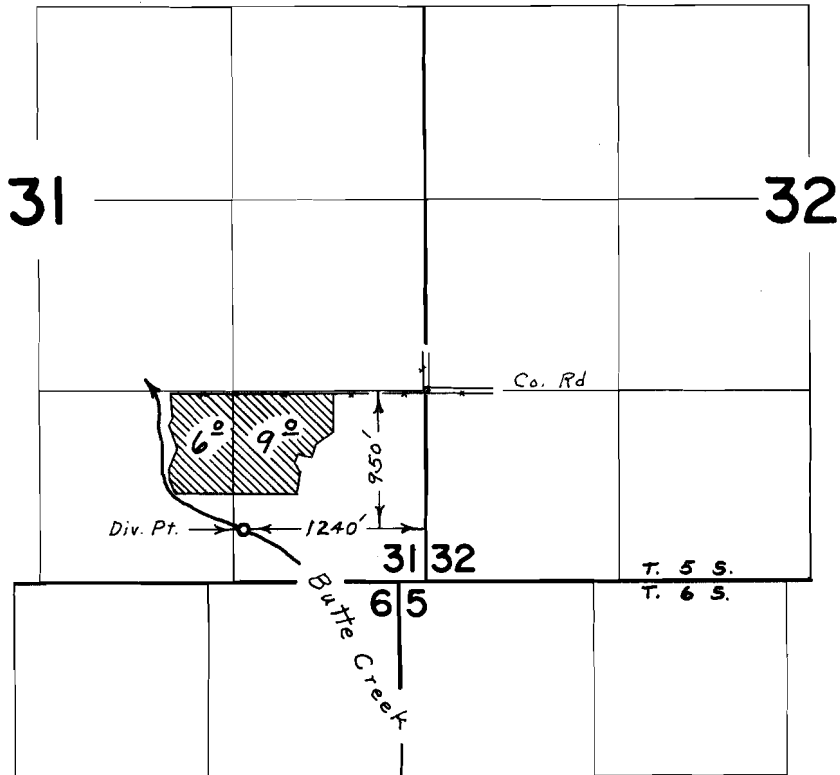

## FINAL PROOF SURVEY UNDER

Application No. 40074 Permit No. 29866  
IN NAME OF

WILFRED B. HATCHER

Surveyed Oct. 20, 1967, by L. E. Gould