


# T.6S.R.1E.W.M.

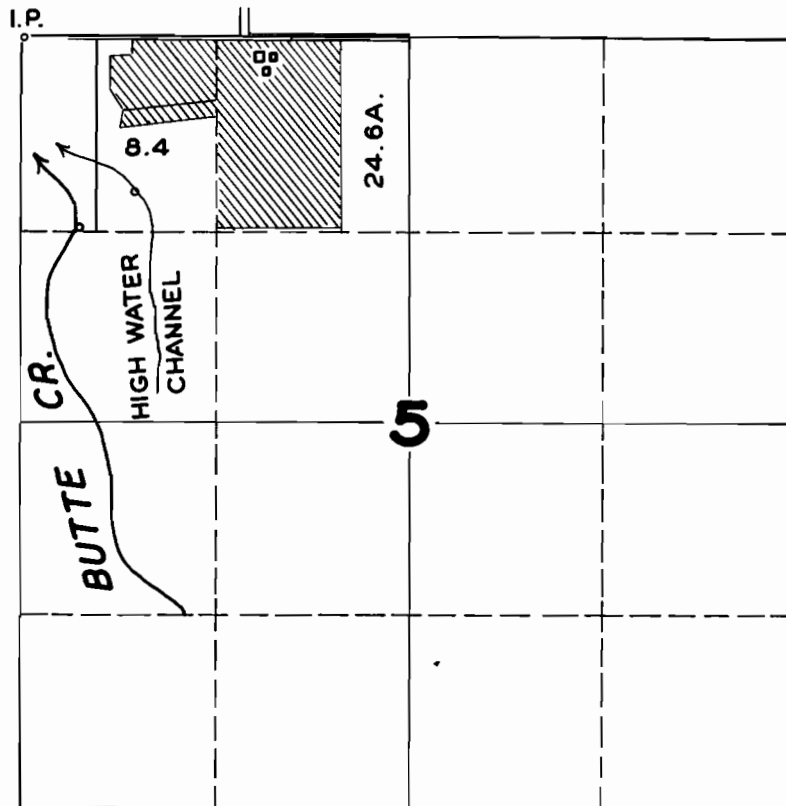

## FINAL PROOF SURVEY

UNDER

Application No. **22615**... Permit No. **17973**...

IN NAME OF

**WALTER BERG**

Surveyed **MAY 5** 1949, by **JAS. E. BUNNELL**