


T.6S.R.1E.W.M.

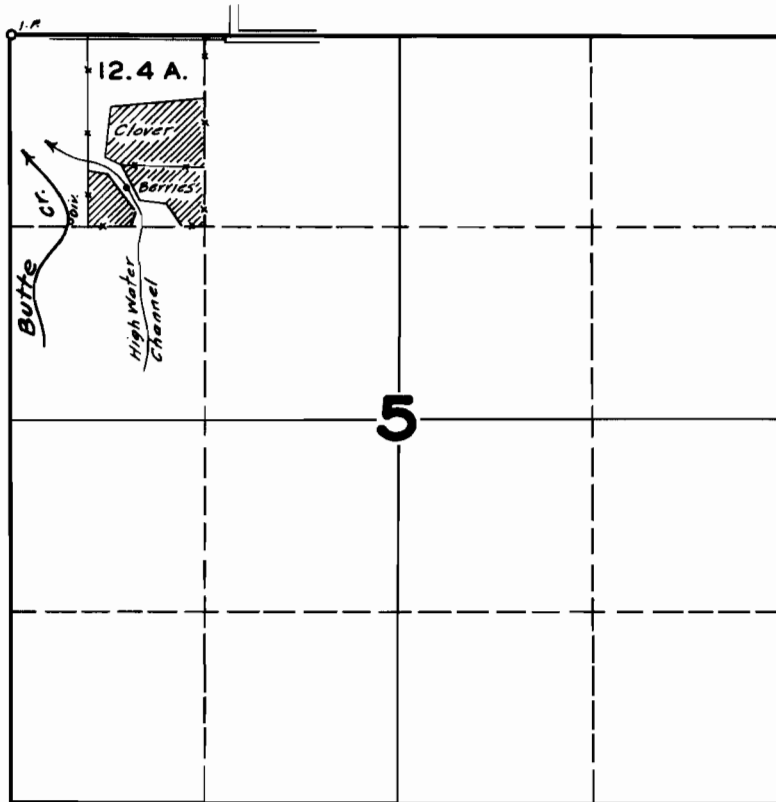

**FINAL PROOF SURVEY
UNDER**

Application No. 21811 Permit No. 17336

IN NAME OF

WALTER BERG

Surveyed OCT. 27 1947, by JAS. E. BUNNELL