


T.8N.R.3 W. W.M.

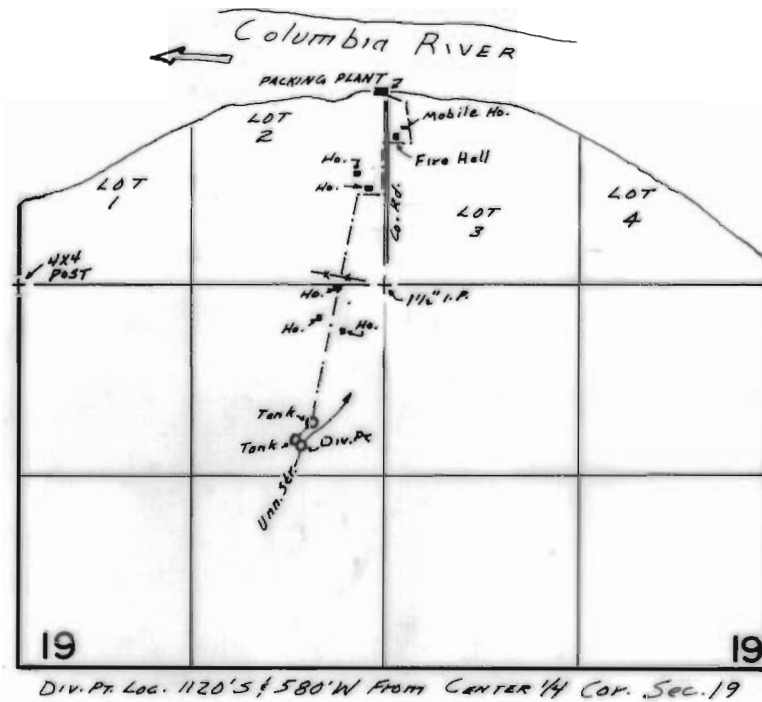

FINAL PROOF SURVEY UNDER

Application No. 50903.. Permit No. 38431.....
IN NAME OF

.....MAYGER WATER SYSTEM.....

Surveyed Aug. 24, 1977, by S.C. BROWN.....