


T.8 N.R.4W. W.M.

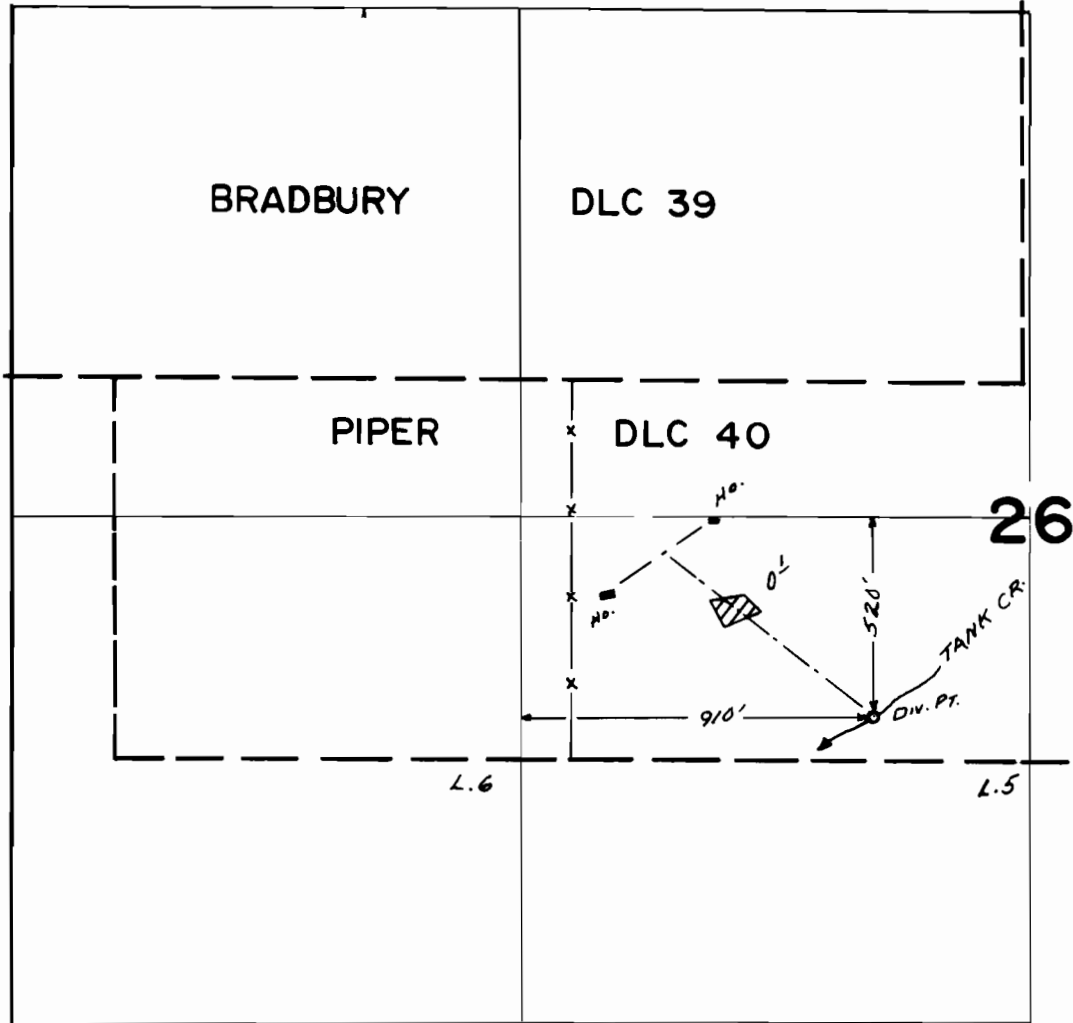

Scale 1" = 500'

FINAL PROOF SURVEY UNDER

Application No. 5105.4 Permit No. 37520
IN NAME OF

..... WILHO E. KARJALA

Surveyed JULY 1, 1976, by L.H. NUNN