


T.5 N. R.2 W. W.M.

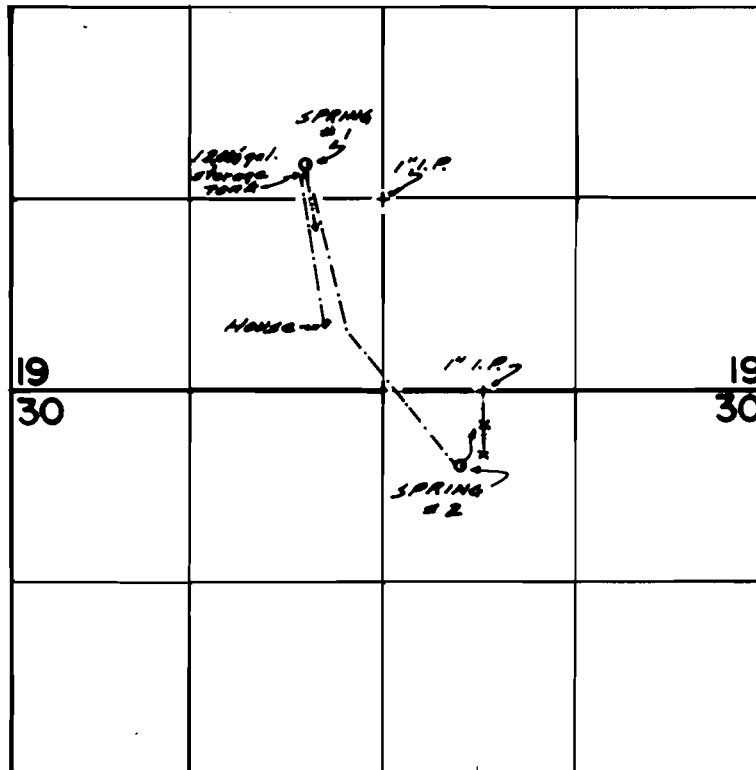

SPRING #1 LOC. - 330' N / 530' W } Both from SW cor. NW, SE, Sec. 19
SPRING #2 LOC. - 1850' S / 530' E }

FINAL PROOF SURVEY
UNDER

Application No. 52894. Permit No. 39917....
IN NAME OF

.....ROSS W. GEORGE.....

Surveyed Aug. 16, 1977, by S.C. BROWN.....