


T. 29S. R. 4W. W. M.

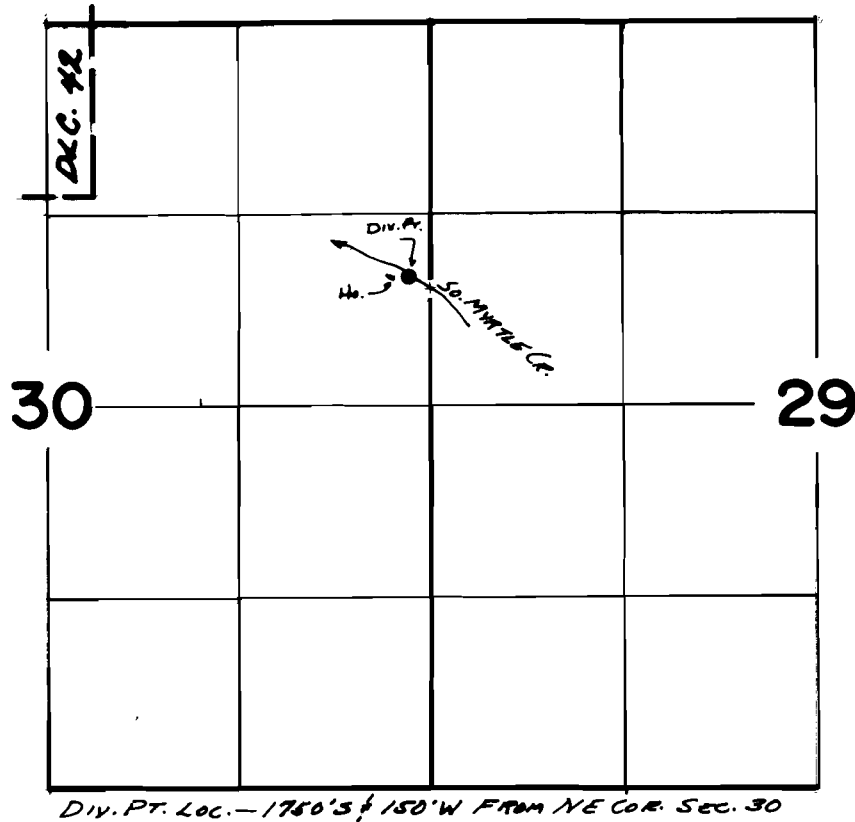

FINAL PROOF SURVEY
UNDER

Application No. 53447... Permit No. 39768...
IN NAME OF

.....**THOMAS M. & FREEDA M. BELL**.....

Surveyed **MAY 20** 1977, by **D.M. NORBY**.....