


T. 29 S., R. 5 W., W.M.

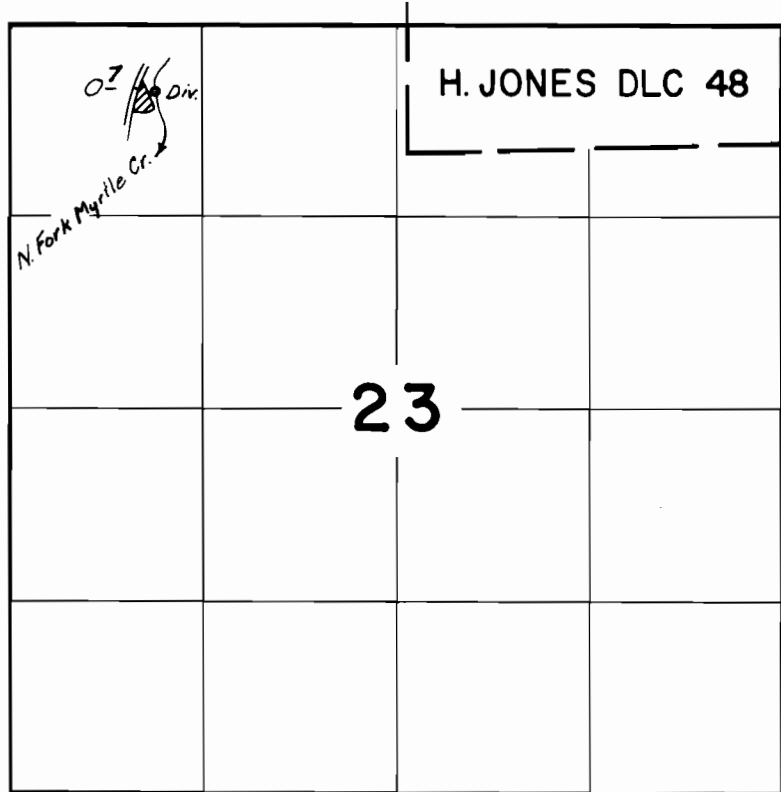

Div. Pt. Loc.: 450 ft. S. & 990 ft. E. from NW Cor. Sec. 23

**FINAL PROOF SURVEY**  
UNDER

Application No. 53768 Permit No. 40376  
IN NAME OF

Charles N. Brown

Surveyed May 26, 1977, by D. Norby