


# T. 29S. R. 4 & 5 W. W.M.

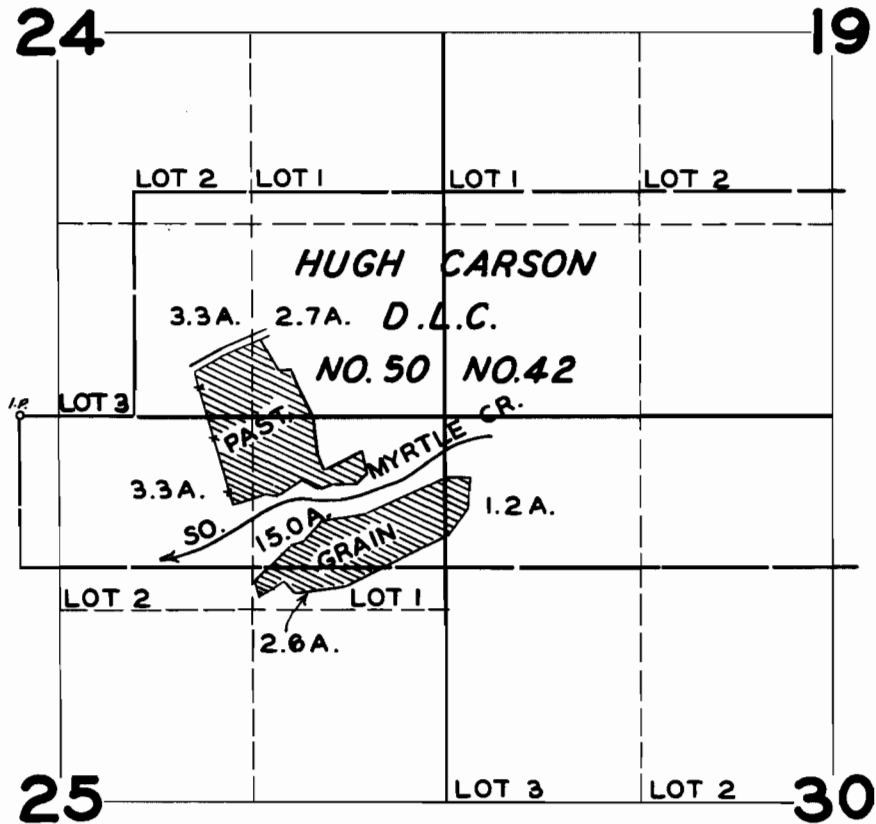

## FINAL PROOF SURVEY UNDER

Application No. 20060 Permit No. 15633

IN NAME OF

GEORGE GATES

Surveyed JUNE 4 1947, by JAS. E. BUNNELL