


T. 1 N. R. 19 E. W. M.

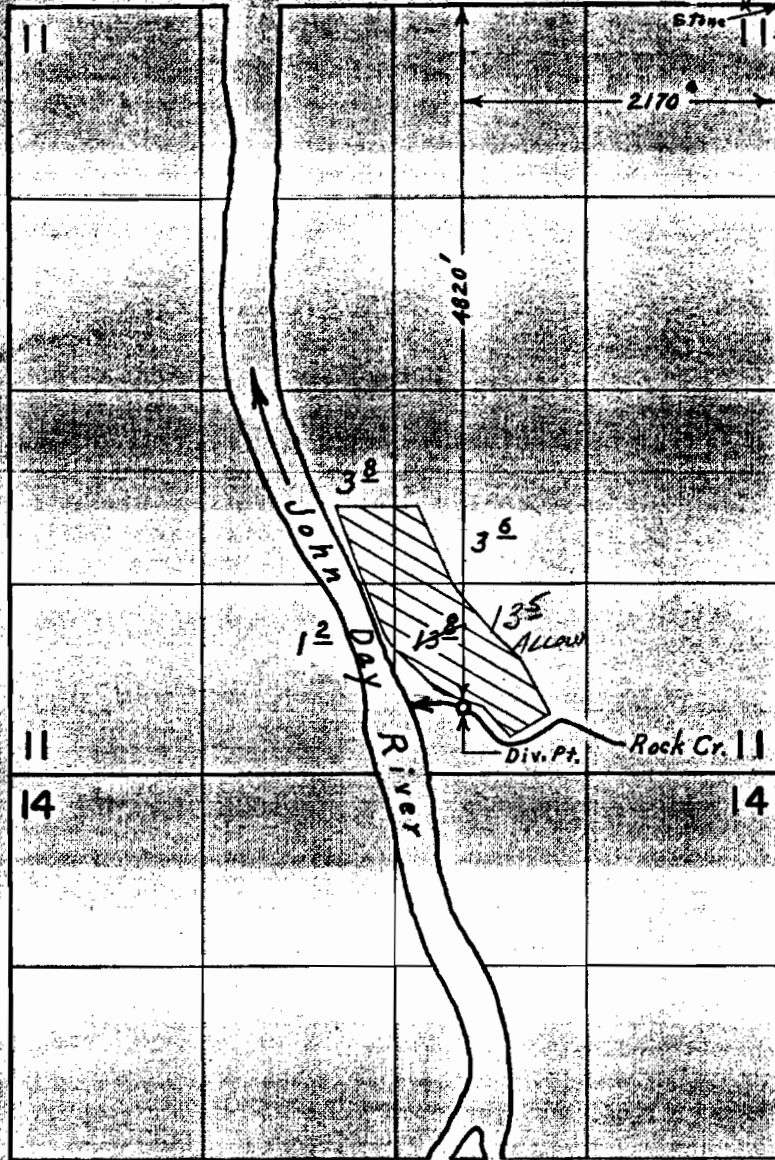

FINAL PROOF SURVEY
UNDER

Application No. 2171 Transfer 2468
Permit No. 40468
IN NAME OF
V. O. WEST

Surveyed 10-25-77 by R.G. ANDERSON
April 9, 1977, by L.F. Gault