


T.1N. R.19E. W.M.

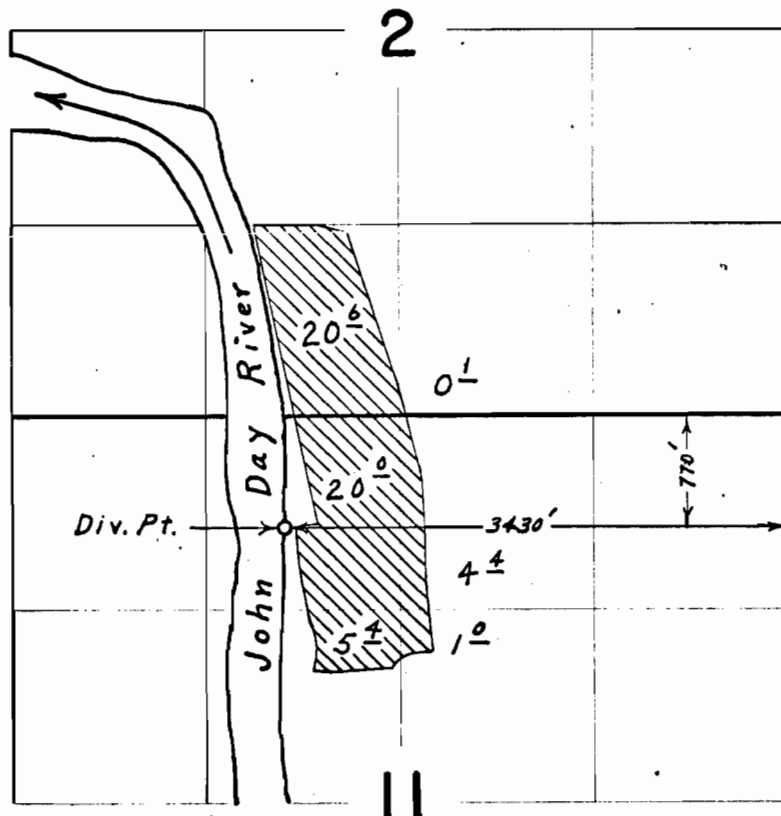

Application No. 53972  
Permit No. 40919

FINAL PROOF SURVEY  
UNDER

Application No. 47815 Permit No. 35847  
IN NAME OF

V. O. WEST

Surveyed April 9, 1974, by L. E. Gould

RECEIVED  
MAR - 1 1976  
WATER RESOURCES DEPT.  
SALEM, OREGON