


P-37740
C-47704

T.13S.R28E.W.M.

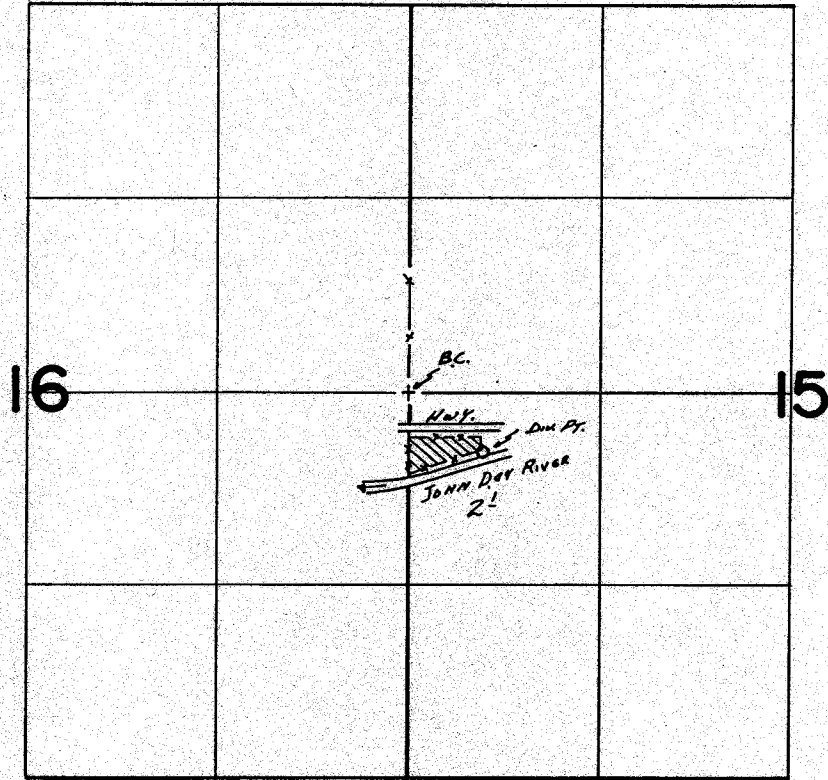

Dist Pt. Loc. 440'S & 500'E From W 1/4 Cor. Sec 15

FINAL PROOF SURVEY
UNDER

Application No. 51637... Permit No. 37740...
IN NAME OF

C-47704

ROBERT C. SHEPHERD & BENISE R. SHERMAN

Surveyed Oct. 20, 1977, by S.C. BROWN.....