


T.28S., R.34E., W.M.

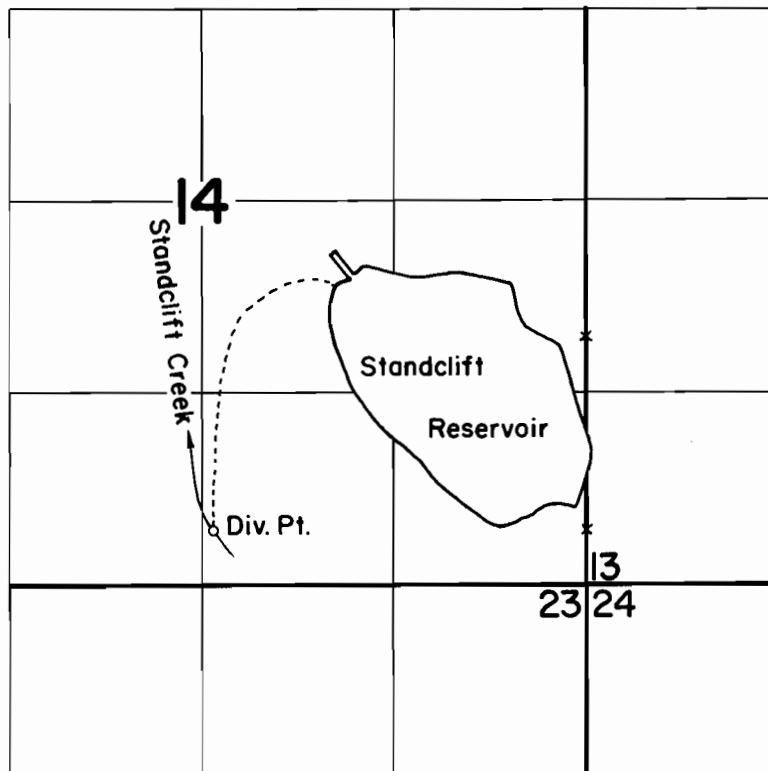

DIV. PT. LOC: Cr.-370' N & 2560' W; Res.-2120' N & 1600' W both
from SE cor. sec. 14

FINAL PROOF SURVEY
UNDER

R-32870 R-2219
Application No. 32871 Permit No. 25962
IN NAME OF

JENKINS BROTHERS

Surveyed April 26, 1976, by D. Norby