


T.IN. RIOE. WM.

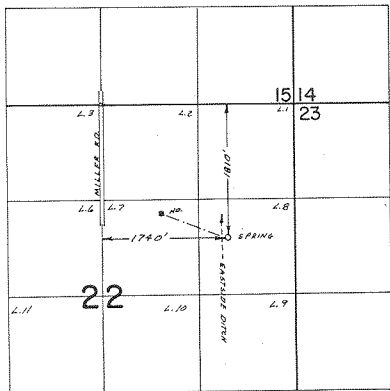

FINAL PROOF SURVEY UNDER

Application No. 54538... Permit No. 40902...
IN NAME OF

CLAY R. SIMON.....

Surveyed OCT. 28, 1977, by L.H. NUNN.....