


T. 34 S., R. 2 W., W.M.

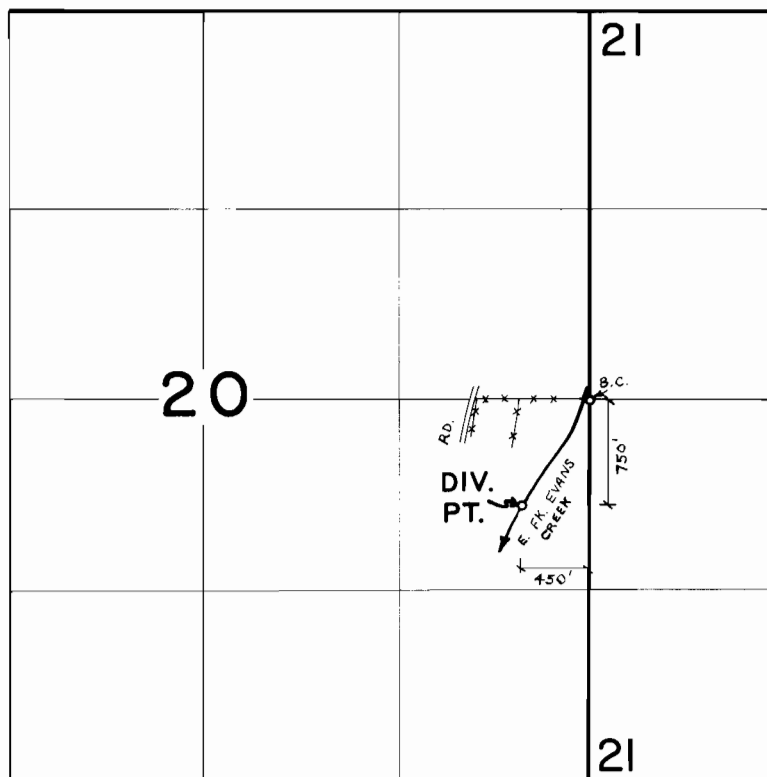

FINAL PROOF SURVEY

UNDER

TR-2373

TR-2374

Application No. Permit No.
IN NAME OF

GERALDINE S. BRYANT

Surveyed APR. 13 1978, by B. SUND

