


T.35S. R.5W. W.M.

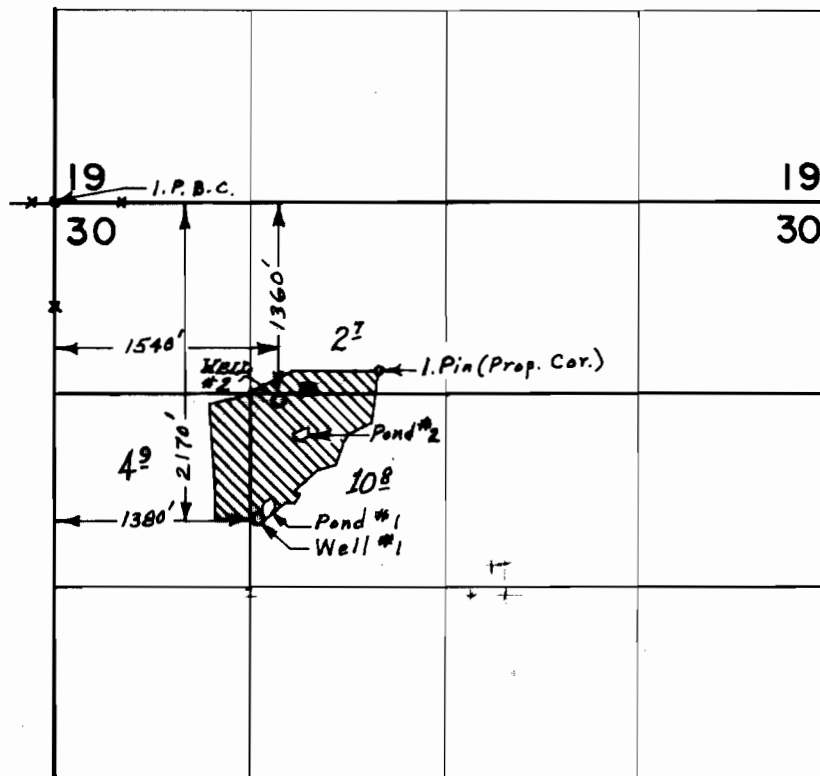

FINAL PROOF SURVEY UNDER

Application No. G-5893 Permit No. G-5167
IN NAME OF

GEORGE RANDOLPH BLANKENSHIP

April 2 1975
Surveyed May 17, 1974, by L. E. Gould
REVISED JUNE 25, 1977 L.M. TOLL